

RANKIN

V61

6174

E 62 394

62

MISSISSIPPI BOARD OF WATER COMMISSIONERS
416 North State Street
Jackson, Mississippi 39201

CODED

WATER WELL DRILLERS LOG

1974 Griner Drilling Service RANKIN
date well completed firm name county well located

LANDOWNER: SHELL OIL

CO. COX #5

H & P Contractor
(mailing address)

WELL LOCATION: Sub 5 w/4 NE 1/4
sec. 29 T. 3 N S R. 3 E W

(distance) miles (direction) of (nearest town)

WELL PURPOSE:
(home, irrigation, municipal, industrial)

WELL COMPLETION DATA:

- (1) diameter (inches) 4"
- (2) total depth (feet) 488 ~~578~~ Ft.
- (3) static water level (feet) 180 below top of ground.
- (4) casing B.T., 412 Ft.
(material) (depth)
4" if telescope see back.
(size)
- (5) screen 20', 412 ⁽⁴¹²⁻⁴²²⁾ ~~(488-498)~~
(length) (depth to top)
4", 304 55
(size) (material)
- (6) pump 5, 45
(HP) (yield gpm)
Elect.
(type power)
- (7) electric log Yes
(yes or no)
MGS
(organization running log)
- (8) how well bottom plugged Back
Wash Valve

description of formations encountered

from

to

Top soil	0	3
CLAY, Hard	3	170
Sandy clay	170	233
CLAY	233	348
Roots & CLAY w/SAND STR.	348	400
CLAY	400	422
SAND	422	424
CLAY	424	446
SAND	446	456
CLAY w/SAND STREAKS	456	482
SAND, FINE	482	500
CLAY	500	540

CODED


REGISTERED
RANKIN
JUL - 5 914

DRILLERS REMARKS:

MISS. BD. OF WATER COMM

If well telescopes please sketch and show depths.

GROUND LEVEL

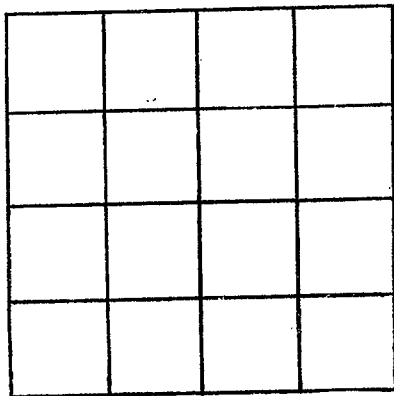

SECTION _____

Please indicate well location X.

ADDITIONAL INFORMATION

If more than one screen,
show locations of each on sketch.