

RANKIN  
V 62  
4-9-74

MISSISSIPPI  
BOARD OF WATER COMMISSIONERS  
416 North State Street  
Jackson, Mississippi 39201

CODED  
CODED

WATER WELL DRILLERS LOG

4/4 date well completed 1974 R. E. Thompson firm name Rankin county well located

LANDOWNER:  
James Curran  
Star Miss.  
(mailing address)

WELL LOCATION:  
sec 29 T 30 N R 30 E  
\_\_\_\_\_ miles \_\_\_\_\_ of \_\_\_\_\_  
(distance) (direction) (nearest town)

WELL PURPOSE:  
(home, irrigation, municipal, industrial)


- WELL COMPLETION DATA:
- (1) diameter (inches) 2"
  - (2) total depth (feet) 241 1/2
  - (3) static water level (feet) 131' below top of ground.
  - (4) casing plastic 130'  
(material) (depth)  
2"  
(size) If telescope see back.
  - (5) screen 10' 130'  
(length) (depth to top)  
1008 plastic  
(size) (material)
  - (6) pump 2 6  
(HP) (yield gpm)  
Jet  
(type power)
  - (7) electric log no  
(yes or no)
- (organization running log)
- (8) how well bottom plugged \_\_\_\_\_

description of formations encountered	from	to
top soil	0	5
gray clay	5	40
blanchy	40	120
hard fine	120	146
CODED		
CODED		
CODED		
RECEIVED		
AUG 14 1974		
MISS. Bd. OF WATER COMMISSION		

DRILLERS REMARKS:

If well telescopes please sketch and show depths.

GROUND LEVEL

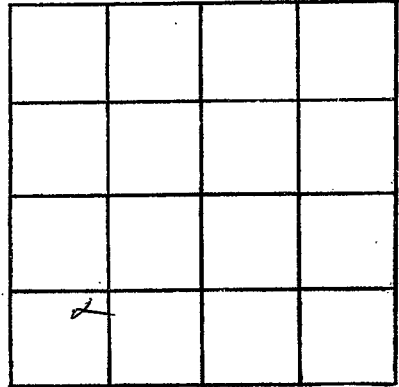

SECTION 39

Please indicate well location X.

ADDITIONAL INFORMATION

If more than one screen, show locations of each on sketch.