

U 64
 RANKIN
 7-9-73

MISSISSIPPI
 BOARD OF WATER COMMISSIONERS
 416 North State Street
 Jackson, Mississippi 39201

COPIED

WATER WELL DRILLERS LOG

July 9 1973 K. E. Thompson Rankin
 date well completed firm name county well located

LANDOWNER:

T. Williams
 (mailing address)

description of formations encountered

from to

Top Soil	0	10
Gray Clay	10	30
Rock	30	32
Blue Clay	32	133
Sand	133	167

WELL LOCATION:

Sec. 11 T. 3 N. R. 2 E.
 S. W.
2 1/2 miles N of Star
 (distance) (direction) (nearest town)

WELL PURPOSE:

(home, irrigation, municipal, industrial)

WELL COMPLETION DATA:

- (1) diameter (inches) 2"
- (2) total depth (feet) 167
- (3) static water level (feet) 66 below top of ground. above
- (4) casing Plastic 152
 (material) (depth)
2" If telescope see back.
 (size)
- (5) screen 10' 152
 (length) (depth to top)
2" Plastic
 (size) (material)
- (6) pump 1 7
 (HP) (yield gpm)
1/2
 (type power)
- (7) electric log no
 (yes or no)

(organization running log)


(8) how well bottom plugged

DRILLERS REMARKS:

AUG 19 1973

If well telescopes please sketch and show depths.

GROUND LEVEL

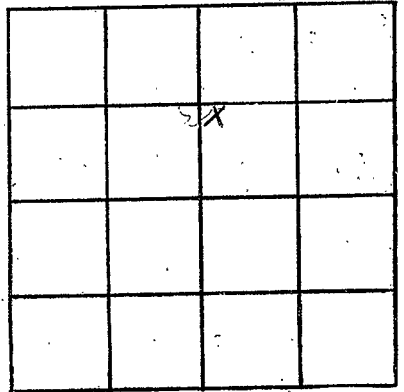

SECTION 11

Please indicate well location X.

ADDITIONAL INFORMATION

If more than one screen, show locations of each on sketch.