

Rankin
 1168
 8-20-75
 E log # 414

MISSISSIPPI
 BOARD OF WATER COMMISSIONERS
 416 North State Street
 Jackson, Mississippi 39201

WATER WELL DRILLERS LOG

CODED

8/20 1975 R. E. Thompson Rankin
 date well completed firm name county well located

LANDOWNER: Elbert Jones
Rt. 3 Box 381
Lorenz
 (mailing address)

WELL LOCATION:
 sec. 7 T 3 N R. 2 E
4 miles W of Lorenz
 (distance) (direction) (nearest town)

WELL PURPOSE: farm
 (home, irrigation, municipal, industrial)

WELL COMPLETION DATA:
 (1) diameter (inches) 4 X 2
 (2) total depth (feet) 360 224
 (3) static water level (feet) 126 below/above top of ground.
 (4) casing Plastic 216'
 (material) (depth)
4 X 2 if telescope see back.
 (size)
 (5) screen 10' 216
 (length) (depth to top)
008 Plastic
 (size) (material)
 (6) pump 1/2 4
 (HP) (yield gpm)
Sub.
 (type power)
 (7) electric log yes
 (yes or no)
M. H. S.
 (organization running log)
 (8) how well bottom plugged Bl'd 90%

description of formations encountered	from	to
top soil	0	2
unsh. clay	2	40
blue clay	40	192
lime stone	192	210
clay	210	216
sand	216	226
clay	226	360

REGISTERED
 15111
 15111
 SEP - 6 1975

MISS. BU. OF WATER COMMISSIONERS

DRILLERS REMARKS:
Well made in
mint spring sand

If well telescopes please sketch and show depths.

GROUND LEVEL

4"
casing


2"
casing

192

216

224

no tail

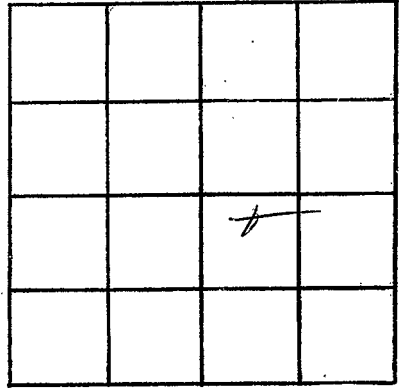

SECTION 7

Please indicate well location X.

ADDITIONAL INFORMATION

If more than one screen,
show locations of each on sketch.