

RANKIN  
U71  
9-16-76  
E log #428

MISSISSIPPI  
BOARD OF WATER COMMISSIONERS  
416 North State Street  
Jackson, Mississippi 39201

COPIED

WATER WELL DRILLERS LOG

9/28/76  
date well completed

19 R. E. Thompson  
firm name

Rankin  
county well located

LANDOWNER:	description of formations encountered	from	to
<u>Lokey Corp</u>	<u>hardly clay</u>	0	80
(mailing address)	<u>Blue clay</u>	80	90
WELL LOCATION:	<u>Blue clay</u>	90	295
sec. <u>19</u> T <u>3</u> N R <u>3</u> E	<u>sand</u>	295	320
S W			
1 miles <u>S/E</u> of <u>Star</u>			
(distance) (direction) (nearest town)			
WELL PURPOSE: <u>Home</u>			
(home, irrigation, municipal, industrial)			
WELL COMPLETION DATA:			
(1) diameter (inches) <u>4 x 2</u>			
(2) total depth (feet) <u>320'</u>			
(3) static water level (feet) <u>245'</u> <sup>below</sup> <u>above</u> top of ground.			
(4) casing <u>Plastic, 300'</u>			
(material) (depth)			
<u>4 x 2</u> If telescope see back.			
(size)			
(5) screen <u>15'</u> , <u>300'</u>			
(length) (depth to top)			
<u>1/4</u> , <u>S.S.</u>			
(size) (material)			
(6) pump <u>1</u> <u>10</u>			
(HP) (yield gpm)			
<u>Sub.</u>			
(type power)			
(7) electric log <u>yes</u>			
(yes or no)			
(organization running log)			
(8) how well bottom plugged <u>M.S.D.</u>			
DRILLERS REMARKS:			


COPIED

RECEIVED  
OCT 19 1976

MISS. BD. OF WATER COMMISSIONERS

If well telescopes please sketch and show depths.

GROUND LEVEL

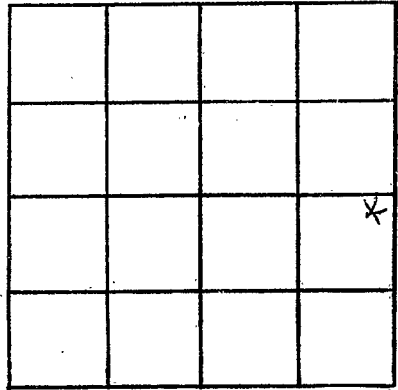

SECTION 19

Please indicate well location X.

ADDITIONAL INFORMATION

4X2 Packer  
279'

4" casing  
side @ 280'

15' x 1/4"  
s.s.  
-008

4' thick

If more than one screen,  
show locations of each on sketch.