

RANKIN
 V74
 3/12/79

MISSISSIPPI
 BOARD OF WATER COMMISSIONERS
 416 North State Street
 Jackson, Mississippi 39201

CODED

WATER WELL DRILLERS LOG

3-12-79 date well completed
 Rankin firm name
 Rankin county well located

LANDOWNER:
 Harvey Jones
 (mailing address)

description of formations encountered	from	to
CLAY SAND	0	205
	205	240

WELL LOCATION:
 sec. 29 T 3 N R 3 E
 (distance) miles (direction) of (nearest town)

WELL PURPOSE:
 (home, irrigation, municipal, industrial)

WELL COMPLETION DATA:

(1) diameter (inches) 4"

(2) total depth (feet) 226

(3) static water level (feet) 140 below above top of ground.

(4) casing PVC 206 (material) (depth)

4 (size) if telescope see back.

(5) screen 20 PVC (length) (depth to top)

4 PVC (size) (material)

(6) pump 1 (HP) 95 (yield gpm)

(type power)

(7) electric log MG S (yes or no) (organization running log)

(8) how well bottom plugged 130 ft


DRILLERS REMARKS:

CODED

Miss. Board of Water Comm.
 Miss. Board of Water Comm.
 APR 25 1979
 RECEIVED

If well telescopes please sketch and show depths.

GROUND LEVEL

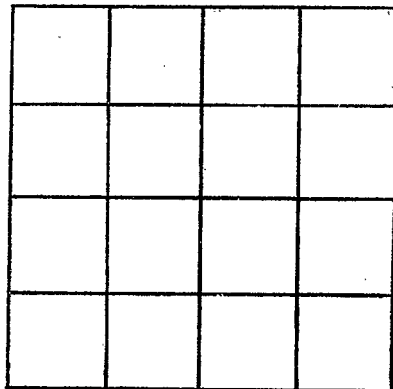

SECTION _____

Please indicate well location X.

ADDITIONAL INFORMATION

A series of horizontal lines for recording additional information, starting below the 'ADDITIONAL INFORMATION' header and extending to the bottom of the page.

If more than one screen, show locations of each on sketch.