

RANKIN  
 U76  
 5-5-80  
 Flag #500

MISSISSIPPI  
 BOARD OF WATER COMMISSIONERS  
 416 North State Street  
 Jackson, Mississippi 39201

CODED

WATER WELL DRILLERS LOG

May 5 1980 R.M. "Bud" Cesswell RANKIN  
 date well completed firm name county well located

LANDOWNER:  
 Shell Oil Company  
 Houston, Texas  
 (mailing address)

| description of formations encountered | from | to   |
|---------------------------------------|------|------|
| Clay-shale                            | 0    | 110  |
| Sand                                  | 110  | 140  |
| Sand-strips sand                      | 140  | 450  |
| Rock                                  | 450  | 500  |
| Clay                                  | 500  | 960  |
| Sand-strips sand                      | 960  | 1180 |
| Sand                                  | 1180 | 1230 |

WELL LOCATION:  
 sec 26 T 3 N R 2 E  
 3 miles S-W of STAR  
 (distance) (direction) (nearest town)

WELL PURPOSE: INDUSTRIAL  
 (home, irrigation, municipal, industrial)

- WELL COMPLETION DATA:
- (1) diameter (inches) 6
  - (2) total depth (feet) 1230
  - (3) static water level (feet) 295 below top of ground
  - (4) casing Steel, 1190 (material) (depth)  
 6 (size) if telescope see back.
  - (5) screen 40, 1190 (length) (depth to top)  
 4, STAINLESS (size) (material)
  - (6) pump 20, 100 (HP) (yield gpm)  
 0 (type power)
  - (7) electric log yes (yes or no)  
 State (organization running log)
  - (8) how well bottom plugged  
 Sand Shards


DRILLERS REMARKS:

DEPT. OF NATURAL RESOURCES  
 BUREAU OF LAND & WATER RESOURCES  
 MAY 28 1980  
 RECEIVED

(X)

If well telescopes please sketch and show depths.

GROUND LEVEL

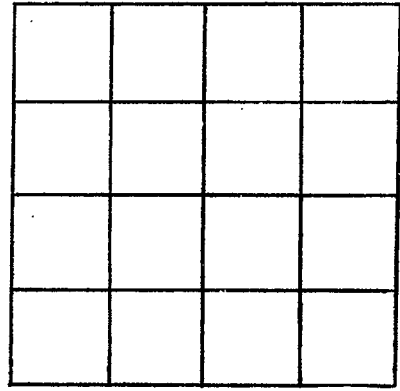

SECTION \_\_\_\_\_

Please indicate well location X.

ADDITIONAL INFORMATION

A series of horizontal lines for recording additional information.

If more than one screen, show locations of each on sketch.