

Rankin  
U 78  
5/16/80

MISSISSIPPI  
 BOARD OF WATER COMMISSIONERS  
 416 North State Street  
 Jackson, Mississippi 39201

CODED

WATER WELL DRILLERS LOG

May 16 1980 E.M. "Bud" Cresswell RANKIN  
 date/well completed firm name county well located

LANDOWNER:  
Pursue Energy Co.  
Fayettee, Ms.  
 (mailing address)

description of formations encountered	from	to
	<u>Clay</u> <u>Sand</u>	<u>0</u> <u>40</u>

WELL LOCATION:  
 sec. 27 T 3 N R. 2 E  
3 miles West of STAR  
 (distance) (direction) (nearest town)

WELL PURPOSE: Industrial  
 (home, irrigation, municipal, industrial)

CODED

WELL COMPLETION DATA:  
 (1) diameter (inches) 6  
 (2) total depth (feet) 75  
 (3) static water level (feet) 40 below above top of ground.  
 (4) casing PVC 55  
 (material) (depth)  
6 if telescope see back.  
 (size)  
 (5) screen 20 55  
 (length) (depth to top)  
6 PVC  
 (size) (material)  
 (6) pump 5 75  
 (HP) (yield gpm)  
0  
 (type power)  
 (7) electric log no  
 (yes or no)  
 (organization running log)

(8) how well bottom plugged  
cap  
 DRILLERS REMARKS:

DEPT. OF NATURAL RESOURCES  
 BUREAU OF LAND & WATER RESOURCES


MAY 28 1980

RECEIVED

(X)

If well telescopes please sketch and show depths.

GROUND LEVEL

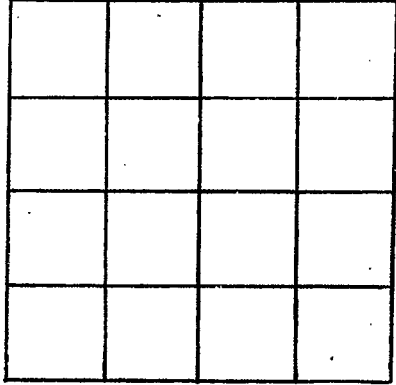

SECTION \_\_\_\_\_

Please indicate well location X.

ADDITIONAL INFORMATION

A series of horizontal lines for recording additional information, starting below the 'ADDITIONAL INFORMATION' header and extending to the bottom of the page.

If more than one screen, show locations of each on sketch.