


Rankin
U. 81

MISSISSIPPI
 BOARD OF WATER COMMISSIONERS
 416 North State Street
 Jackson, Mississippi 39201

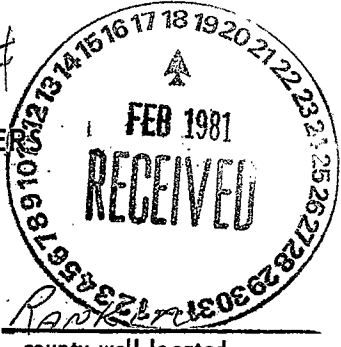

WATER WELL DRILLERS LOG

1/19/81
Jan. 19

81 E.M. Bud "Cresswell"

Rankin

date well completed

firm name

county well located

LANDOWNER:

Pursue Energy Co.
Lafayette, LA.
 (mailing address)

description of formations encountered

from

to

Shale 0 110
Sand 110 150

WELL LOCATION:

sec. *30* T *13* N R *2* E
8 44
7 miles *South* of *Florence*
 (distance) (direction) (nearest town)

WELL PURPOSE: *INDUSTRIAL*
 (home, irrigation, municipal, industrial)

WELL COMPLETION DATA:

- (1) diameter (inches) *3*
- (2) total depth (feet) *150*
- (3) static water level (feet) *175* below top of ground. above
- (4) casing *Steel*, *130*
 (material) (depth)
- 3*
 (size) if telescope see back.
- (5) screen *20*, *130*
 (length) (depth to top)
- 3*, *STAINLESS*
 (size) (material)
- (6) pump *Air Compressor*
 (HP) (yield gpm)
- 0*
 (type power)
- (7) electric log *No*
 (yes or no)

(organization running log)

(8) how well bottom plugged

Ball Plug


DRILLERS REMARKS:

DEPT. OF NATURAL RESOURCES
 BUREAU OF LAND & WATER RESOURCES

FEB 18 1981
 RECEIVED

If well telescopes please sketch and show depths.

GROUND LEVEL

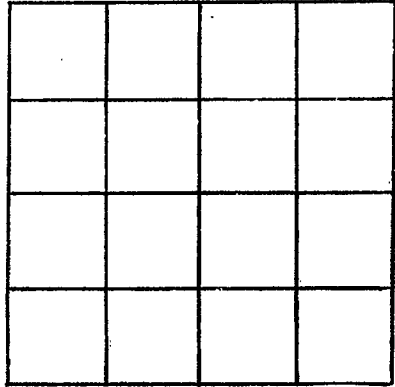

SECTION _____

Please indicate well location X.

ADDITIONAL INFORMATION

If more than one screen, show locations of each on sketch.