


RANKIN  
 U84  
 9-30-82

MISSISSIPPI  
 BOARD OF WATER COMMISSIONERS  
 416 North State Street  
 Jackson, Mississippi 39201

CODED

WATER WELL DRILLERS LOG

9-30-82 date well completed 1982 firm name *Gunn well ser* county well located *RANKIN*

LANDOWNER: <i>Gerald MARTIN</i>	description of formations encountered	from	to
(mailing address)	<i>CLAY SAND</i>	<i>0</i>	<i>260</i> <i>26 270</i>
WELL LOCATION: sec <i>14</i> T <i>3N</i> R <i>2E</i> S W			
(distance) miles _____ of _____ (direction) (nearest town)			
WELL PURPOSE: (home, irrigation, municipal, industrial)			
WELL COMPLETION DATA: (1) diameter (inches) <i>4"</i> (2) total depth (feet) <i>270</i> (3) static water level (feet) <i>20</i> below top of ground. (4) casing <i>PVC</i> <i>270</i> (material) (depth) <i>4"</i> (size) If telescope see back. (5) screen <i>20</i> <i>270</i> (length) (depth to top) <i>47</i> <i>PVC</i> (size) (material) (6) pump <i>1</i> <i>15</i> (HP) (yield gpm) (type power) (7) electric log _____ (yes or no) (organization running log) (8) how well bottom plugged <i>1300V</i>			

DRILLERS REMARKS:


DEPT. OF NATURAL RESOURCES  
 BUREAU OF LAND & WATER RESOURCES

NOV 30 1982

RECEIVED

If well telescopes please sketch and show depths.

GROUND LEVEL

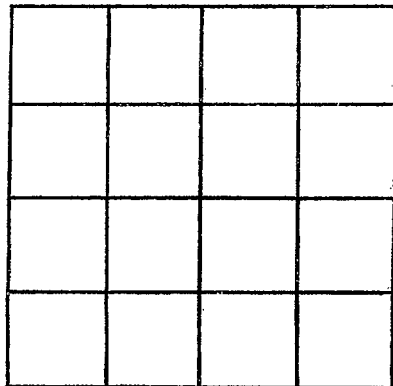

SECTION \_\_\_\_\_

Please indicate well location X.

ADDITIONAL INFORMATION

If more than one screen, show locations of each on sketch.