

RANKIN
U 86
11/4/82

MISSISSIPPI
BOARD OF WATER COMMISSIONERS
416 North State Street
Jackson, Mississippi 39201

CODED ✓

WATER WELL DRILLERS LOG

11/4/82 date well completed 19 Jack Quinn Water Well firm name Rankin county well located

LANDOWNER: Horace Whitfield
Florence, Ms
(mailing address)

WELL LOCATION:
sec. 36 T. 3 N R. 2 E
8 miles SE of Stone
(distance) (direction) (nearest town)

WELL PURPOSE: None
(home, irrigation, municipal, industrial)

- WELL COMPLETION DATA:
- (1) diameter (inches) 4"
 - (2) total depth (feet) 282
 - (3) static water level (feet) 180 below above top of ground.
 - (4) casing PVC, 260'
(material) (depth)
4" If telescope see back.
(size)
 - (5) screen 20', 260'
(length) (depth to top)
4" PVC
(size) (material)
 - (6) pump 3/4 10
(HP) (yield gpm)
electricity
(type power)
 - (7) electric log Yes
(yes or no)
Ms. Bureau of Geology
(organization running log)
 - (8) how well bottom plugged Backwash
Valve

description of formations encountered	from	to
Clay	1	80
Sand	81	140
CLAY	141	160
Rock	161	180
Shale	181	260
Sand	261	282

CODED

DEPT. OF NATURAL RESOURCES
BUREAU OF LAND & WATER RESOURCES


DEC - 7 1982

RECEIVED

DRILLERS REMARKS:

If well telescopes please sketch and show depths.

GROUND LEVEL

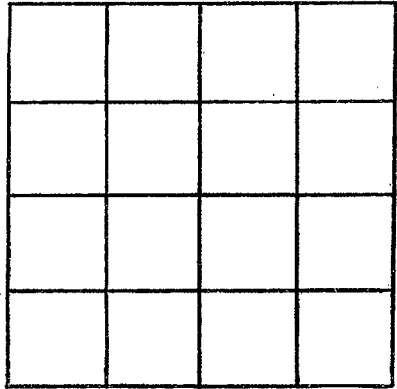

SECTION _____

Please indicate well location X.

ADDITIONAL INFORMATION

If more than one screen, show locations of each on sketch.