

MISSISSIPPI DEPARTMENT OF NATURAL RESOURCES

Bureau of Land and Water Resources

Southport Mall

P.O. Box 10631

Jackson, Mississippi 39209

WATER WELL DRILLERS LOG

CODED
Rankin

RANKIN
U87
3/22/83

3/22 1983 Jack Guinn Water Wells firm name Wells Rankin county well located

LANDOWNER: J. T. Dale

description of formations encountered from to

(mailing address)

WELL LOCATION:
 sec. 8 (T) 3 (N) R. 2 (E)
3 miles (distance) E (direction) of Florence (nearest town)

WELL PURPOSE: Home
 (home, irrigation, municipal, industrial)

WELL COMPLETION DATA:

- (1) diameter (inches) 4 in.
- (2) total depth (feet) 389 ft.
- (3) static water level (feet) 180 below top of ground.
- (4) casing P.V.C. 210 ft.
 (material) (depth)
4 in. (size) if telescopic see back.
- (5) screen 12 ft., 228
 (length) (depth to top)
4 in. (size), P.V.C. (material)
- (6) pump 1/2 (HP), 7 (yield gpm)
Electric (type power)
- (7) electric log yes (yes or no)
M.A.S. (organization running log)
Back wash valve
- (8) how well bottom plugged

DRILLERS REMARKS:

top soil	0	30
sand material	30	60
Brown clay	60	100
Shell	100	150
Blue clay	150	200
Rock & sand	200	260

CODED


DEPT. OF NATURAL RESOURCES
 BUREAU OF LAND & WATER RESOURCES

MAY 3 1983

RECEIVED

If well telescopes please sketch and show depths.

GROUND LEVEL

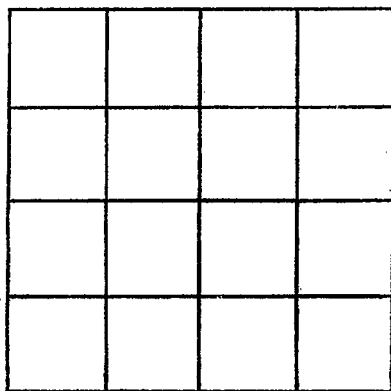

SECTION _____

Please indicate well location X.

ADDITIONAL INFORMATION

If more than one screen, show locations of each on sketch.