

U88 Elog 555

Rankin

8-16-84

MISSISSIPPI BOARD OF WATER COMMISSIONERS

416 North State Street

Jackson, Mississippi 39201

LOG

WATER WELL DRILLERS LOG

8-16 date well completed

firm name

Rankin county well located

LANDOWNER: Crossing
Randy Callan

description of formations encountered

from to

CLAY 0 40
SAND 40 55
CLAY 55 220
SAND 220 240

(mailing address)

WELL LOCATION:

sec 29 T 3 N R 2 E
S W

(distance) miles (direction) of (nearest town)

WELL PURPOSE:

(home, irrigation, municipal, industrial)

WELL COMPLETION DATA:

- (1) diameter (inches) 4"
- (2) total depth (feet) 240
- (3) static water level (feet) 190 "below top of ground"
- (4) casing PVC 220 (material) (depth)
- 4" (size) if telescope see back.
- (5) screen 20' 220 (length) (depth to top)
- 4" (size) PVC (material)
- (6) pump 1 10 (HP) (yield gpm)

-289 m e t y

(type power)

(7) electric log (yes or no)

M & S (organization running log)

(8) how well bottom plugged


BWV

Red 240 1-7-85

DRILLERS REMARKS:

If well telescopes please sketch and show depths.

GROUND LEVEL

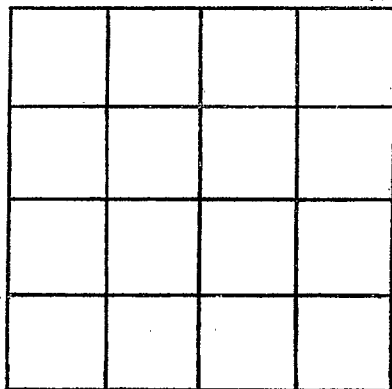

SECTION _____

Please indicate well location X.

ADDITIONAL INFORMATION

If more than one screen,
show locations of each on sketch.