

Coded

RANKIN  
U 89  
4-25-85

MISSISSIPPI  
BOARD OF WATER COMMISSIONERS  
416 North State Street  
Jackson, Mississippi 39201

WATER WELL DRILLERS LOG

4-25-85 date well completed 19 88 firm name Guinn well ser Rankin county well located

LANDOWNER:  
George White  
  
(mailing address)

description of formations encountered	from	to
CLAY	0	60
ROCK	60	78
CLAY	78	120
shaly CLAY	120	200
CLAY	200	240
Sand	240	260

WELL LOCATION:  
sec. 14 T 3 N R. 2 E  
miles of (distance) (direction) (nearest town)

WELL PURPOSE:  
(home, irrigation, municipal, industrial)


- WELL COMPLETION DATA:
- (1) diameter (inches) 4"
  - (2) total depth (feet) 260
  - (3) static water level (feet) 160 below top of ground.
  - (4) casing PVC (material) 240 (depth)
  - 4" (size) If telescope see back.
  - (5) screen 20" (length) 240' (depth to top)
  - 4" (size) PVC (material)
  - (6) pump 1 (HP) 10 (yield gpm)

(type power)

(7) electric log M. HS (yes/or no)  
(organization running log)

(8) how well bottom plugged 130W

DRILLERS REMARKS:

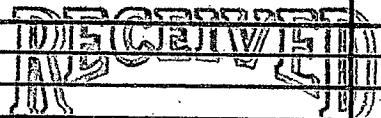


JUN 25 1986

Department of Natural Resources  
Bureau of Land & Water Resources

If well telescopes please sketch and show depths.

GROUND LEVEL

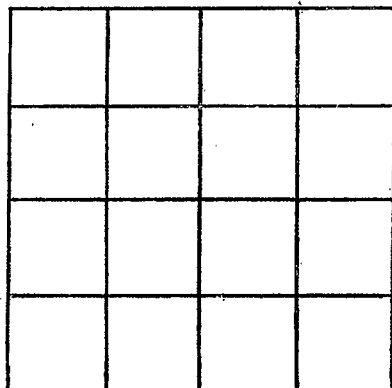

SECTION \_\_\_\_\_

Please indicate well location X.

ADDITIONAL INFORMATION

If more than one screen, show locations of each on sketch.