

MISSISSIPPI DEPARTMENT OF NATURAL RESOURCES

Bureau of Land and Water Resources

Southport Mall

P.O. Box 10631

Jackson, Mississippi 39209

WATER WELL DRILLERS LOG

CODED

RANKIN
U 90

Aug. 15
date well completed

86 E.M. Bud Cresswell RANKIN
firm name

county well located

LANDOWNER:
Rob Berry
Florence, MS.
(mailing address)

description of formations encountered	from	to
Surface -	0	60
Sand -	60	85

WELL LOCATION:
sec. 10 T 3 N R 2 E
3 miles South of Florence
(distance) (direction) (nearest town)

CODED

WELL PURPOSE: Home
(home, irrigation, municipal, industrial)

- WELL COMPLETION DATA:
- (1) diameter (inches) 4
 - (2) total depth (feet) 85
 - (3) static water level (feet) 45 below top of ground
 - (4) casing PVC 75 (material) (depth)
4 (size) If telescope see back.
 - (5) screen 10 75 (length) (depth to top)
4 PVC (size) (material)
 - (6) pump 1 20 (HP) (yield gpm)
 - (7) electric log no (yes or no)
 - (8) how well bottom plugged Back wash

RECEIVED


AUG 26 1996

Department of Natural Resources
Bureau of Land & Water Resources

DRILLERS REMARKS:

If well telescopes please sketch and show depths.

GROUND LEVEL

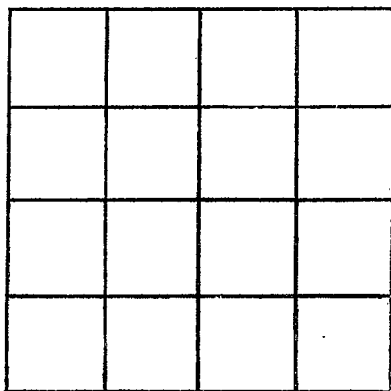

SECTION _____

Please indicate well location X.

ADDITIONAL INFORMATION

If more than one screen, show locations of each on sketch.