

Ranbin  
U 2000  
6 / 76

MISSISSIPPI  
 BOARD OF WATER COMMISSIONERS  
 416 North State Street  
 Jackson, Mississippi 39201

WATER WELL DRILLERS LOG

JUNE 1976 W. G. Butler Ranbin  
 date well completed firm name county well located

LANDOWNER:  
Mary Estelle Richardson  
Florence, Miss-Rt.  
 (mailing address)

WELL LOCATION:  
NE 1/4 of NW 1/4 of  
sec 10 T 31 N R 2 E  
S W  
Art. 3 - miles 5 E of Florence  
 (distance) (direction) (nearest town)

WELL PURPOSE: HOME  
 (home, irrigation, municipal, industrial)

- WELL COMPLETION DATA:
- (1) diameter (inches) 2"
  - (2) total depth (feet) 107
  - (3) static water level (feet) 30 (below/above top of ground)
  - (4) casing galv. 84'  
 (material) (depth)  
2" If telescope see back.  
 (size)
  - (5) screen 5' 84'  
 (length) (depth to top)  
2" S. Steel  
 (size) (material)
  - (6) pump 3/4 6 gal.  
 (HP) (yield (gpm))  
Electric  
 (type power)
  - (7) electric log No  
 (yes or no)
- (organization running log)
- (8) how well bottom plugged 2" B.W.V.


description of formations encountered	from	to
Clay	0	5
Rocky	5	18
Sand & Clay	18	30
Clay + Rocky	30	40
Blue Clay	40	45
Rocky	45	66
Sand + Rocky	66	70
Chalk + Sand	70	80
Chalk	80	84
Sand	84	100
Chalk	100	107

DRILLERS REMARKS:

RECORDED  
 INDEXED  
 JUN 1 1976  
 MISS. BO. OF WATER COMMISSIONERS

If well telescopes please sketch and show depths.

GROUND LEVEL

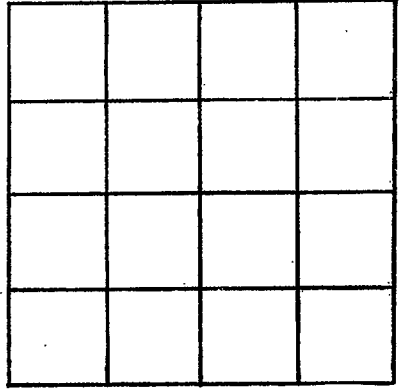

SECTION 160

Please indicate well location X.

ADDITIONAL INFORMATION

If more than one screen,  
show locations of each on sketch.