

Rankin
U 2001

MISSISSIPPI
BOARD OF WATER COMMISSIONERS
416 North State Street
Jackson, Mississippi 39201

CODED

WATER WELL DRILLERS LOG

11/9/82 19 Jack Quinn Water Well Serv. Rankin
date well completed firm name county well located

LANDOWNER: Joseph T. Hale
Florence, Ms.
(mailing address)
WELL LOCATION:
sec. 8 T 3 N R 2 E
3 1/2 miles S of Florence
(distance) (direction) (nearest town)

WELL PURPOSE: Home
(home, irrigation, municipal, industrial)

- WELL COMPLETION DATA:
- (1) diameter (inches) 4"
 - (2) total depth (feet) 478'
 - (3) static water level (feet) 128 below above top of ground.
 - (4) casing PVC 310'
(material) (depth)
4" if telescope see back.
(size)
 - (5) screen 20 310'
(length) (depth to top)
4" PVC
(size) (material)
 - (6) pump 1 10
(HP) (yield gpm)
electricity
(type power)
 - (7) electric log Yes
(yes or no)
Bureau of Geology
(organization running log)
 - (8) how well bottom plugged Backwash
valve

description of formations encountered	from	to
<u>Clay</u>	<u>1</u>	<u>90</u>
<u>Sandy Shale</u>	<u>91</u>	<u>210</u>
<u>Sand</u>	<u>211</u>	<u>260</u>
<u>Clay</u>	<u>261</u>	<u>290</u>
<u>Sand</u>	<u>291</u>	<u>340</u>
<u>Shaly Sand</u>	<u>341</u>	<u>400</u>
<u>Clay</u>	<u>401</u>	<u>478</u>

CODED

DEPT. OF NATURAL RESOURCES
BUREAU OF LAND & WATER RESOURCES


DEC - 7 1982

RECEIVED

DRILLERS REMARKS:

If well telescopes please sketch and show depths.

GROUND LEVEL

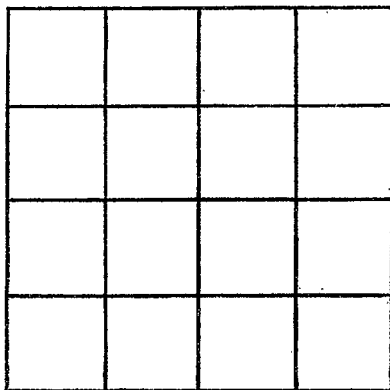

SECTION _____

Please indicate well location X.

ADDITIONAL INFORMATION

If more than one screen, show locations of each on sketch.