

RANKIN
W17
10-10-67

MISSISSIPPI
 BOARD OF WATER COMMISSIONERS
 416 North State Street
 Jackson, Mississippi 39201

ELOG #180

CODED

WATER WELL DRILLERS LOG

10/10 1967 R. E. Thompson Rankin
 date well completed firm name county well located

LANDOWNER:
R. E. Walker
Memphis, Tenn
 (mailing address)

description of formations encountered	from	to
<u>Surface</u>	<u>0</u>	<u>5</u>
<u>B. clay</u>	<u>5</u>	<u>7.3</u>
<u>fine sand</u>	<u>7.3</u>	<u>7.5</u>
<u>blue clay</u>	<u>9.5</u>	<u>11.4</u>
<u>sand</u>	<u>11.4</u>	<u>12.7</u>

WELL LOCATION:
 sec 21 T 3 N R 4 E
6 miles W of Duckett
 (distance) (direction) (nearest town)

WELL PURPOSE: Home
 (home, irrigation, municipal, industrial)

- WELL COMPLETION DATA:
- (1) diameter (inches) 2"
 - (2) total depth (feet) 12.7'
 - (3) static water level (feet) 6.8' below top of ground.
 - (4) casing Galv. 117'
 (material) (depth)
2" if telescope see back.
 (size)
 - (5) screen 10' 117'
 (length) (depth to top)
1/4" S.S.
 (size) (material)
 - (6) pump 3/4 6
 (HP) (yield gpm)
Just
 (type power)
 - (7) electric log yes
 (yes or no)
M. S. S.
 (organization running log)
 - (8) how well bottom plugged B/W/Ch

CODED


FEB 24 1971

DRILLERS REMARKS:

MISS. BD. OF
 WATER COM.

If well telescopes please sketch and show depths.

GROUND LEVEL

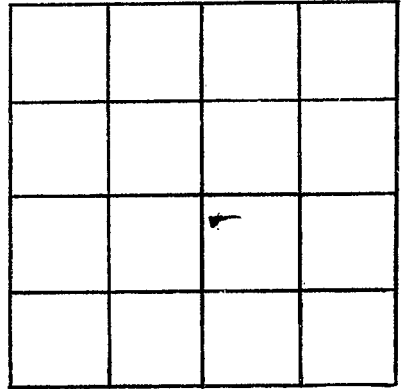

SECTION 21

Please indicate well location X.

ADDITIONAL INFORMATION

If more than one screen, show locations of each on sketch.