

RANKIN MISSISSIPPI BOARD OF WATER COMMISSIONERS

79

W20
5-23-62

WATER WELL DRILLERS LOG

CODED Rankin

Date: 5/23, 1962, Driller: Eugene White County: Rankin
(Name)

(1) Owner of Land: I B Clark
(Name)

Rt 2 Mendenhall
(Address)

(2) Location: 1/4, 1/4, Sec. 23 T. 3R. 4,

N miles 5, of Jacks
(distance) (direction) (Nearest Town)

(3) Topography: _____
(Hilly) (Flat) (Level)

(4) Purpose of Well: Domestic
(Domestic Irrigation
Municipal, Industrial, Other)

Information upon completion of well:

(1) Diameter: 2 inches.

(2) Total Depth: 127 feet.

(3) Water Level: 40 feet below top of ground.

(4) Cased to 90, Size 2"

(5) Screen: Size open, Length _____

(6) Were any formations sealed against pollution?

____ yes, ____ no.


If YES depth of formation _____

Why _____

Drillers Remarks: _____

Description & Color of Materials Sand, Clay, Red Clay, Shell, etc.	Thick- ness Feet	Depth Feet
Red Clay	15	15
Sand	15	30
Blue Shell	90	120
Sand	7	127

CODED

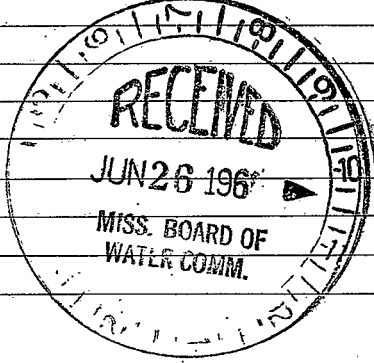

(Use Back Side)

Well No.

1944

1944