

W 21

9-22-62

WATER WELL DRILLERS LOG

CODED

Date: Sept. 22, 1962 Driller: W. G. Butler County Smith
 (Name)

(1) Owner of Land:	Description & Color of Materials Sand, Clay, Red Clay, Shell, etc.	Thick- ness Feet	Depth Feet
<u>J. I. Gill</u> (Name)	<u>Red Clay + Chalk</u>	<u>1-</u>	<u>10</u>
<u>Brandon, Rtd. Miss</u> (Address)	<u>sand + chalk</u>	<u>10-</u>	<u>30</u>
(2) Location: _____ 1/4, _____ 1/4, Sec. <u>1 T3N R4E</u>	<u>Blue Chalk</u>	<u>30-</u>	<u>45</u>
<u>1</u> miles <u>South</u> , of <u>Johns</u> (distance) (direction) (Nearest Town)	<u>Chalk + Sand</u>	<u>45-</u>	<u>60</u>
(3) Topography: _____ (Hilly) (Flat) (Level)	<u>Sand</u>	<u>60-</u>	<u>75</u>
(4) Purpose of Well: <u>Domestic</u> (Domestic Irrigation Municipal, Industrial, Other)			


CODED

Information upon completion of well:

- (1) Diameter 2" inches.
- (2) Total Depth 75 feet.
- (3) Water Level 2.5 feet below top of ground.
- (4) Cased to 6.3, Size 2"
- (5) Screen: Size 2", Length 10
- (6) Were any formations sealed against pollution?
 _____ yes, _____ no.

If YES depth of formation _____
 Why _____

Drillers Remarks: _____

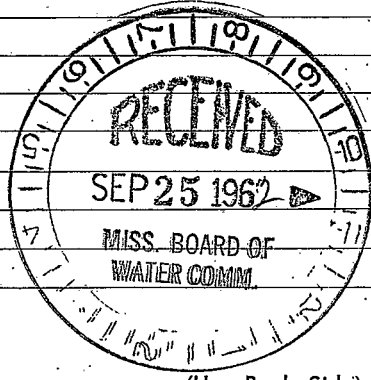

(Use Back Side)

Well No.

0000