

RANKIN MISSISSIPPI BOARD OF WATER COMMISSIONERS

W22
5-24-63

WATER WELL DRILLERS LOG

CODED with


Date: May 24, 1963, Driller: W. G. Butler County: Smith
(Name)

(1) Owner of Land: <u>Lynn Jones</u> (Name) <u>Jacksons</u> (Address)	Description & Color of Materials Sand, Clay, Red Clay, Shell, etc. <u>Clay + Chalk</u> <u>Rock</u> <u>Rock + Chalk</u> <u>Rock, Chalk, + Sand</u> <u>Sand + Chalk</u> <u>Rock</u> <u>Sand</u>	Thick- ness Feet <u>1-</u> <u>5-20</u> <u>20-40</u> <u>40-50</u> <u>50-55</u> <u>55-57</u> <u>57-68</u>	Depth Feet <u>5</u> <u>20</u> <u>40</u> <u>50</u> <u>55</u> <u>57</u> <u>68</u>
(2) Location: <u>21 3/4</u> <u>45</u> T. R. <u>6</u> miles <u>South</u> of <u>Johns</u> (distance) (direction) (Nearest Town)			
(3) Topography: _____ (Hilly) (Flat) (Level)			
(4) Purpose of Well: <u>Domestic</u> (Domestic Irrigation Municipal, Industrial, Other)			

Information upon completion of well:

- (1) Diameter 2 inches.
- (2) Total Depth 65 feet.
- (3) Water Level 40 feet below top of ground.
- (4) Cased to 63', Size 2"
- (5) Screen: Size 2", Length 5'
- (6) Were any formations sealed against pollution?
 _____ yes, _____ no.

If YES depth of formation _____
 Why _____
 Drillers Remarks: _____

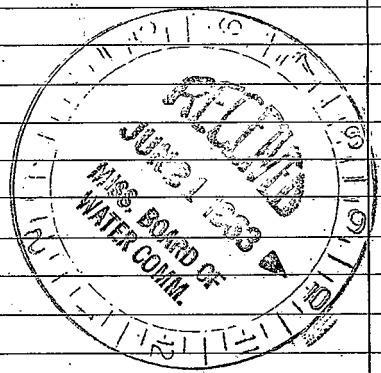

(Use Back Side)

Well No.

134