

RANKIN MISSISSIPPI BOARD OF WATER COMMISSIONERS

~~Q 23~~ W 23

10-29-62


WATER WELL DRILLERS LOG

**CODED**

Date: Oct. 29, 1962, Driller: W. G. Butler County Smith  
(Name)

		Description & Color of Materials Sand, Clay, Red Clay, Shell, etc.	Thick- ness Feet	Depth Feet
(1) Owner of Land:	<u>W. P. Boone</u> (Name)	<u>Chalk + Rock</u>	<u>1-</u>	<u>10</u>
	<u>Brandon, Miss</u> (Address)	<u>Chalk, Rock + sand</u>	<u>10-</u>	<u>20</u>
(2) Location:	<u>1/4, 1/4, Sec. 5</u> <u>6 miles S. West of Cato</u> (distance) (direction) (Nearest Town)	<u>Rock</u>	<u>20-</u>	<u>35</u>
		<u>sand</u>	<u>35-</u>	<u>40</u>
(3) Topography:	<input checked="" type="checkbox"/> (Hilly) <input type="checkbox"/> (Flat) <input type="checkbox"/> (Level)	<u>sand + streak of Chalk</u>	<u>40-</u>	<u>45</u>
(4) Purpose of Well:	<u>Domestic</u> (Domestic Irrigation Municipal, Industrial, Other)	<u>Chalk + Rock</u>	<u>45-</u>	<u>50</u>
		<u>Rock + chalk</u>	<u>50-</u>	<u>60</u>
		<u>Rock</u>	<u>60-</u>	<u>64</u>
		<u>sand</u>	<u>64-</u>	<u>66</u>
		<u>Rock</u>	<u>66-</u>	<u>90</u>
		<u>Rock + shell</u>	<u>70-</u>	<u>100</u>
		<u>Rock + sand</u>	<u>100-</u>	<u>120</u>
		<u>Blue Shale</u>	<u>120-</u>	<u>130</u>
		<u>Rock + shale</u>	<u>130-</u>	<u>138</u>
		<u>Red sand</u>	<u>138-</u>	<u>143</u>
		<u>Shale</u>	<u>143-</u>	<u>150</u>
		<u>Fine sand</u>	<u>150-</u>	<u>155</u>
		<u>Rock + shale</u>	<u>155-</u>	<u>160</u>
		<u>Fine sand</u>	<u>160-</u>	<u>165</u>
		<u>Rock + shale</u>	<u>165-</u>	<u>170</u>
		<u>Rock</u>	<u>170-</u>	<u>180</u>
		<u>Rock + shale</u>	<u>180-</u>	<u>197</u>
		<u>sand</u>	<u>197-</u>	<u>238</u>
		<u>Chalk</u>	<u>238-</u>	<u>244</u>
Information upon completion of well:				
(1) Diameter	<u>2"</u> inches.			
(2) Total Depth	<u>244</u> feet.			
(3) Water Level	<u>35'</u> feet below top of ground.			
(4) Cased to	<u>42'</u> , Size <u>2"</u>			
(5) Screen: Size	<u>2"</u> , Length <u>5'</u>			
(6) Were any formations sealed against pollution?	<u>no.</u>			
	<u>yes,</u> <u>no.</u>			
If YES depth of formation				
Why				
Drillers Remarks:				

**CODED**

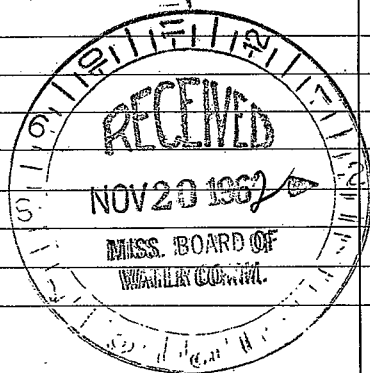

(Use Back Side)

Well No.

1942

1942