

RANKIN MISSISSIPPI BOARD OF WATER COMMISSIONERS

W 24

6-12-63

WATER WELL DRILLERS LOG

CODED

June 12 63

W. B. Butler

Smith

Date: \_\_\_\_\_, 19\_\_\_\_, Driller: \_\_\_\_\_ County \_\_\_\_\_  
 (Name)

(1) Owner of Land: J. W. Fortenberry  
Bradlow, Miss.  
 (Name)  
 (Address)

(2) Location: \_\_\_\_\_ 1/4, \_\_\_\_\_ 1/4, Sec. \_\_\_\_\_ T R  
7 S Johns  
 miles \_\_\_\_\_ of \_\_\_\_\_  
 (distance) (direction) (Nearest Town)

(3) Topography: \_\_\_\_\_  
 (Hilly) Domestic (Flat) (Level)

(4) Purpose of Well: \_\_\_\_\_  
 (Domestic Irrigation  
 Municipal, Industrial, Other)

Description & Color of Materials Sand, Clay, Red Clay, Shell, etc.	Thick- ness Feet	Depth Feet
Rock	5	5
sand	15	19
Rock + chalk	17	36
Rock + sand	50	70
Rock, chalk, sand	70	80
Rock + sand	80	130
Rock	130	140
Rock + sand	140	150
Rock	150	160
Rock + chalk	160	190
sand	190	195
chalk + sand	195	210

Information upon completion of well:

(1) Diameter 2 inches.  
2 10

(2) Total Depth \_\_\_\_\_ feet.  
40

(3) Water Level \_\_\_\_\_ feet below top of  
 ground. 61


(4) Cased to \_\_\_\_\_ Size 2"  
NONE

(5) Screen: Size \_\_\_\_\_, Length \_\_\_\_\_

(6) Were any formations sealed against pollution?  
 \_\_\_\_\_ yes, \_\_\_\_\_ no.

If YES depth of formation \_\_\_\_\_  
 Why \_\_\_\_\_

Drillers Remarks: \_\_\_\_\_  
 \_\_\_\_\_  
 \_\_\_\_\_

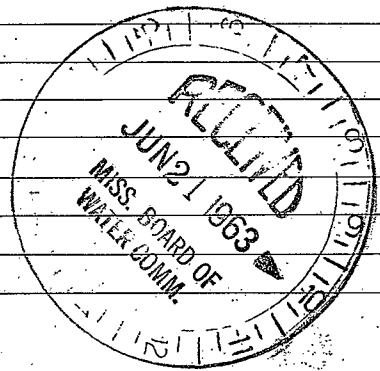

(Use Back Side)

Well No.

100

100

100

100