

RANKIN MISSISSIPPI BOARD OF WATER COMMISSIONERS

W 27
2-21-64

WATER WELL DRILLERS LOG

CODED

Date: Feb. 21, 1964, Driller: W. H. Ratten, County: Smith
(Name)

(1) Owner of Land: Martha Bass
(Name)
Brandon, Miss.
(Address)

(2) Location: 1/4, 1/4, Sec. 31 T. 44 N. R. 4 E.
6 miles West of Johns,
(distance) (direction) (Nearest Town)

(3) Topography: (Hilly) (Flat) (Level)

(4) Purpose of Well: Domestic
(Domestic Irrigation
Municipal, Industrial, Other)

Description & Color of Materials Sand, Clay, Red Clay, Shell, etc.	Thick- ness Feet	Depth Feet
Red sand	1-10	
Sand + Chalk	10-20	
Rock + Chalk	20-60	
Chalk	60-68	
Sand	68-70	
Rock + Chalk	70-110	
Chalk + Sand	110-130	
Chalk	130-140	
Rock + Chalk	140-150	
Sand + Chalk	150-160	
Chalk	160-165	
Sand	165-170	
Chalk	170-175	
Sand	175-201	

Information upon completion of well:

(1) Diameter: 8 inches.

(2) Total Depth: 201 feet.

(3) Water Level: 90 feet below top of ground.

(4) Cased to: 189', Size _____


(5) Screen: Size 2', Length 10'

(6) Were any formations sealed against pollution?
_____ yes, _____ no.

If YES, depth of formation _____

Why _____

Drillers Remarks: _____

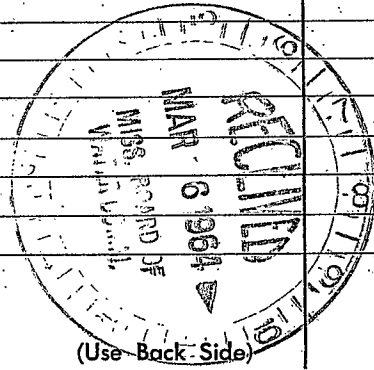

Well No. _____

[The page contains extremely faint and illegible text, likely bleed-through from the reverse side of the document. The text is scattered across the page and does not form any recognizable words or sentences.]