

CODED

MISSISSIPPI
BOARD OF WATER COMMISSIONERS
416 North State Street
Jackson, Mississippi 39201

Rankin
W 31
12-67

WATER WELL DRILLERS LOG

Dec 1, 1967 W.G. Butler Rankin
date well completed firm name county well located

LANDOWNER:

Bobby Fortenberry
Mendenhall - Rt -
(mailing address)

description of formations encountered

from

to

Red Clay + Rock	0	10
Blue Chalk + Rock	10	40
" " " + sand	40	60
Sand (fine)	60	75
Sand + Rock	75	80
Sand, rock lignite	80	90
Chalk + Fine Sand	90	95
Rock Chalk + Sand	95	100
Rock + Chalk	100	110
Rock + Brown Chalk	110	120
Brown Chalk	120	127
Rock	127	130
Rock + Chalk	130	140
Chalked lignite	140	145
Sand	145	164

WELL LOCATION:


sec 28 T 3 N R 4 E
S W
4 miles S of Johns
(distance) (direction) (nearest town)

WELL PURPOSE:

home
(home, irrigation, municipal, industrial)

WELL COMPLETION DATA:

- (1) diameter (inches) 2"
- (2) total depth (feet) 164
- (3) static water level (feet) 40 ^{below} _{above} top of ground.
- (4) casing galv. 154'
(material) (depth)
2" if telescope see back.
(size)
- (5) screen 10' 154'
(length) (depth to top)
2" Stainless Steel
(size) (material)
- (6) pump 1 10
(HP) (yield gpm)
Electric
(type power)
- (7) electric log No
(yes or no)
(organization running log)
- (8) how well bottom plugged 2" BWV

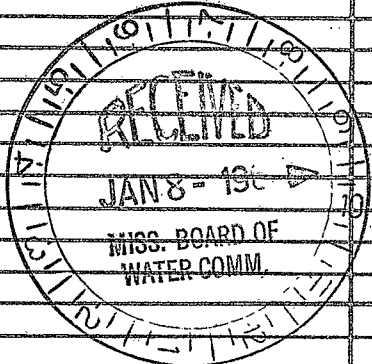

DRILLERS REMARKS:

If well telescopes please sketch and show depths.

GROUND LEVEL

			X

SECTION 24

Please indicate well location X.

ADDITIONAL INFORMATION

If more than one screen, show locations of each on sketch.