

MISSISSIPPI BOARD OF WATER COMMISSIONERS

W-33
 inc info to locate
~~3-18-61~~
 3-18-61

WATER WELL DRILLERS

CODED? Rankin
 Smith

Date: MARCH 18, 1961, Driller: W.G. Butler County SMITH
 (Name)

(1) Owner of Land: Billy Styron
 (Name)
Rt. 1 Braxton, Miss.
 (Address)

(2) Location: 1/4, 1/4, Sec 20 T3R4
6 miles South, of Johns
 (distance) (direction) (Nearest Town)

(3) Topography: ✓
 (Hilly) (Flat) (Level)

(4) Purpose of Well: Domestic
 (Domestic Irrigation
 Municipal, Industrial, Other)

| Description & Color of Materials Sand, Clay, Red Clay, Shell, etc. | Thick- ness Feet | Depth Feet |
|---|------------------------|---------------|
| TOP SOIL | 0-1 | |
| Clay | 1-5 | |
| Rock | 5-10 | |
| Rock Formation | 10-20 | |
| Gumbo | 20-30 | |
| Gumbo + Rock | 30-40 | |
| " " | 40-50 | |
| Rock | 50-57 | |
| A little Sand | 57-60 | |
| Sand + chalk | 60-70 | |
| Fine sand | 70-80 | |
| Sand + chalk | 80-90 | |
| Sand | 90-120 | |

Information upon completion of well:

(1) Diameter 2 inches.

(2) Total Depth 120 feet.

(3) Water Level 70 feet below top of ground.


(4) Cased to 115, Size 2"

(5) Screen: Size 1 1/4, Length 5'

(6) Were any formations sealed against pollution?
 _____ yes, _____ no.

If YES depth of formation _____
 Why _____

Drillers Remarks: _____

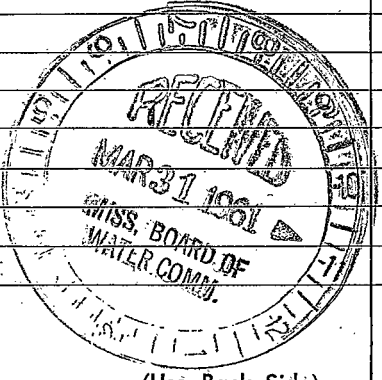

(Use Back Side)

Well No.

