

Rankin
W 34
7-8-68

MISSISSIPPI
BOARD OF WATER COMMISSIONERS
416 North State Street
Jackson, Mississippi 39201

CODED

WATER WELL DRILLERS LOG

July 8 1968 M. G. Butler Rankin
date well completed firm name county well located


LANDOWNER:
Roy Ainsworth
Braxton, Miss Rtl.
(mailing address)

description of formations encountered	from	to
Chalk + Rock	0	20
Sand + Rock	20	40
Sand	40	60

WELL LOCATION:
sec 15 T 3 N R 4 E
S W
3 miles SW of Johns
(distance) (direction) (nearest town)

WELL PURPOSE:
(home, irrigation, municipal, industrial)


- WELL COMPLETION DATA:
- (1) diameter (inches) 2"
 - (2) total depth (feet) 60'
 - (3) static water level (feet) 40' below top of ground.
 - (4) casing PVC, 50' (material) (depth)
4" (size) if telescope see back.
 - (5) screen 10' 50' (length) (depth to top)
2" (size) SS (material)
 - (6) pump 1/2 Submersible (HP) 10 (yield gpm)
Electric (type power)
 - (7) electric log No (yes or no)
(organization running log)
 - (8) how well bottom plugged 2" BML

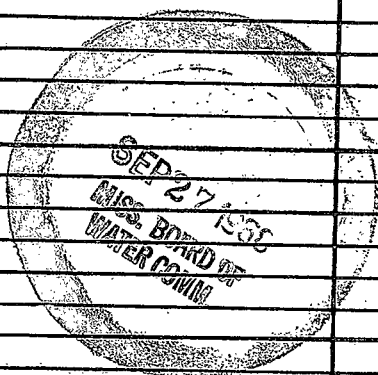

DRILLERS REMARKS:

If well telescopes please sketch and show depths.

GROUND LEVEL

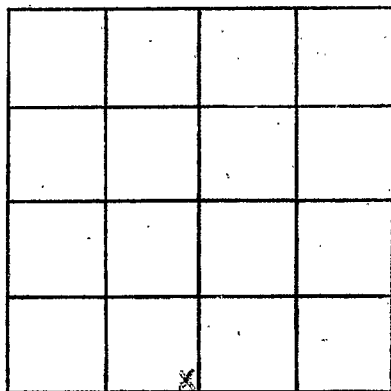

SECTION 15

Please indicate well location X.

ADDITIONAL INFORMATION

If more than one screen,
show locations of each on sketch.