

Rankin
W 35
9-4-68

MISSISSIPPI
BOARD OF WATER COMMISSIONERS
416 North State Street
Jackson, Mississippi 39201

CODED

WATER WELL DRILLERS LOG

Sept 22 - 1968 W.G. Butten Rankin
date well completed firm name county well located

LANDOWNER:
D.W. (Bill) Fontenbury
Bryant Rt. 1
(mailing address)


description of formations encountered	from	to
Chalk & Rock	0	10
Rock	10	20
Chalk & Rock	20	70
Chalk & Sand	70	80
Chalk	80	100
Chalk + Rock	100	140
Chalk Rock & little Sand	140	150
Chalk + Sand	150	190
Good Sand	190	200
Sand	200	207

WELL LOCATION:
sec. 21 T-3 N R-4 E
3 1/2 miles S of Johns
(distance) (direction) (nearest town)

WELL PURPOSE:
(home, irrigation, municipal, industrial)


- WELL COMPLETION DATA:
- (1) diameter (inches) 2"
 - (2) total depth (feet) 200'
 - (3) static water level (feet) 60 ^{below}/_{above} top of ground.
 - (4) casing 92/11, 192'
(material) (depth)
2" If telescope see back.
(size)
 - (5) screen 15' 192'
(length) (depth to top)
2" S.S.
(size) (material)
 - (6) pump Air Comp 20
(HP) (yield gpm)
Electric
(type power)
 - (7) electric log NA
(yes or no)
(organization running log)
 - (8) how well bottom plugged 2" BWV

DRILLERS REMARKS:

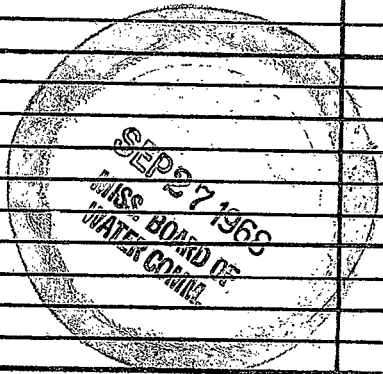

If well telescopes please sketch and show depths.

GROUND LEVEL

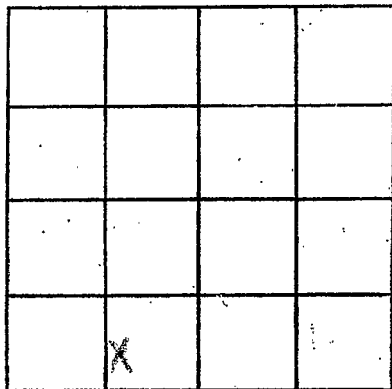

SECTION 21

Please indicate well location X.

ADDITIONAL INFORMATION

If more than one screen,
show locations of each on sketch.