

CODED

Rankin
W 30
1-7-69

MISSISSIPPI
BOARD OF WATER COMMISSIONERS
416 North State Street
Jackson, Mississippi 39201

WATER WELL DRILLERS LOG

CODED

Jan 7 1969 W.G. Butler Rankin
date well completed firm name county well located

LANDOWNER:

Foy Rogers
Brandon Miss.
(mailing address)

description of formations encountered

from to

Sand + Rock
Chalk + Sand
Sand
0 5
5 100
100 110

WELL LOCATION:

sec. 16 T 3 N R. 4 E
ACROSS HWY From Rock Hill Church
3 miles W of Johns
(distance) (direction) (nearest town)

WELL PURPOSE: home
(home, irrigation, municipal, industrial)

WELL COMPLETION DATA:

- (1) diameter (inches) 2"
- (2) total depth (feet) 110'
- (3) static water level (feet) 15' below top of ground.
- (4) casing 92% V. 105'
(material) (depth)
2" if telescope see back.
(size)
- (5) screen 5' 105'
(length) (depth to top)
2" S.S.
(size) (material)
- (6) pump 3/4 (HP) 10 (y'eld gpm)
Electric
(type power)
- (7) electric log No
(yes or no)

CODED

(organization running log)

(8) how well bottom plugged 2" B.W.V.


MAR 13 1969

DRILLERS REMARKS:

MISS. BD. OF
WATER COMM.

If well telescopes please sketch and show depths.

GROUND LEVEL

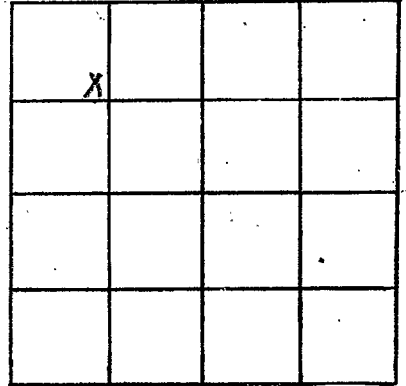

SECTION 16

Please indicate well location X.

ADDITIONAL INFORMATION

If more than one screen,
show locations of each on sketch.