

E LOG # 228

Rankin  
W42  
8-25-69  
U.S.G.S.

MISSISSIPPI  
BOARD OF WATER COMMISSIONERS  
416 North State Street  
Jackson, Mississippi 39201

CODED

WATER WELL DRILLERS LOG

aug 25, 1969 19 W. E. Thompson Warner  
date well completed firm name county well located

LANDOWNER:

C. A. Hall  
catto miss.  
(mailing address)

description of formations encountered

from

to

WELL LOCATION:

sec 22 T 3 N R 4 E  
4 miles S of John's  
(distance) (direction) (nearest town)

WELL PURPOSE: Drain  
(home, irrigation, municipal, industrial)

WELL COMPLETION DATA:

- (1) diameter (inches) 2"
- (2) total depth (feet) 468'
- (3) static water level (feet) 38 below top of ground.
- (4) casing Plastic, 444  
(material) (depth)  
2" if telescope see back.  
(size)
- (5) screen 20' 444  
(length) (depth to top)  
2" Plastic  
(size) (material)
- (6) pump 1 1/2 43  
(HP) (yield gpm)  
air well  
(type power)
- (7) electric log yes  
(yes or no)  
U.S.G.S.  
(organization running log)
- (8) how well bottom plugged 2/27/69


<u>clay</u>	<u>0</u>	<u>60</u>
<u>sand Red</u>	<u>60</u>	<u>90</u>
<u>Blue clay</u>	<u>90</u>	<u>230</u>
<u>limestone</u>	<u>230</u>	<u>320</u>
<u>Brown clay</u>	<u>320</u>	<u>420</u>
<u>sand</u>	<u>420</u>	<u>468</u>

DRILLERS REMARKS:

SEP 1 1969  
MISS. Bd. of  
WATER COMMISSIONERS  
SEP 1  
E  
WATER C.

If well telescopes please sketch and show depths.

GROUND LEVEL

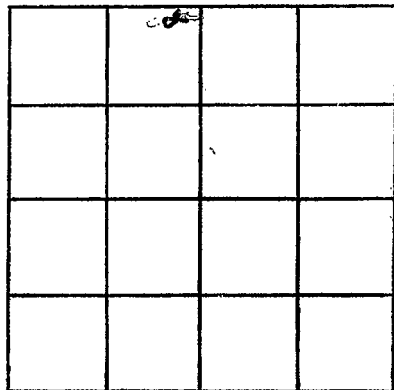

SECTION 22

Please indicate well location X.

ADDITIONAL INFORMATION

If more than one screen,  
show locations of each on sketch.