

Rankin
W 94
6-27-69

MISSISSIPPI
 BOARD OF WATER COMMISSIONERS
 416 North State Street
 Jackson, Mississippi 39201

CODED

WATER WELL DRILLERS LOG

June 27 1969 N. E. Thompson Wells Rankin
 date well completed firm name county well located


LANDOWNER:	description of formations encountered	from	to
<u>Thomas Stevens</u>			
<u>Boarder miss.</u> (mailing address)	<u>Rock.</u>	<u>5</u>	<u>9</u>
WELL LOCATION: sec. <u>5</u> T <u>3</u> N R <u>4</u> E <u>5</u> miles <u>West</u> of <u>Jacks</u> (distance) (direction) (nearest town)	<u>Bray clay.</u>	<u>9</u>	<u>20</u>
WELL PURPOSE: <u>industrial</u> (home, irrigation, municipal, industrial)	<u>Blue clay & Rock.</u>	<u>20</u>	<u>136</u>
WELL COMPLETION DATA: (1) diameter (inches) <u>2"</u>	<u>Sand.</u>	<u>136</u>	<u>171</u>
(2) total depth (feet) <u>171'</u>			
(3) static water level (feet) <u>28'</u> below top of ground.			
(4) casing <u>Plaster, 16 5/8"</u> (material) (depth) <u>2"</u> if telescope see back. (size)			
(5) screen <u>6"</u> <u>16 5/8"</u> (length) (depth to top) <u>2 1/2"</u> <u>Plaster</u> (size) (material)			
(6) pump <u>1</u> <u>11</u> (HP) (yield gpm) <u>Gas</u> (type power)			
(7) electric log <u>no</u> (yes or no)			
(organization running log)			
(8) how well bottom plugged <u>Not plugged</u>			
DRILLERS REMARKS:			

JUL 7 1969

Mississippi
 Board of Water
 Commissioners
 Jackson, Mississippi

If well telescopes please sketch and show depths.

GROUND LEVEL

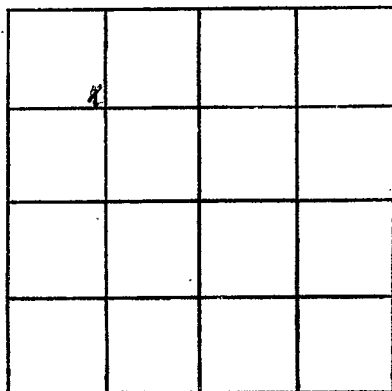

SECTION 5

Please indicate well location X.

ADDITIONAL INFORMATION

If more than one screen, show locations of each on sketch.