

Rankin
W 47.
8-28-69
M.G.S.

MISSISSIPPI
 BOARD OF WATER COMMISSIONERS
 416 North State Street
 Jackson, Mississippi 39201

CODED

WATER WELL DRILLERS LOG

Aug 28 1969 W. E. Thompson firm name W 47 Rankin county well located
 date well completed

LANDOWNER:
Paul Burnham
W. 2 Mendenhall Miss.
 (mailing address)

description of formations encountered	from	to
<u>Red clay</u>	<u>0</u>	<u>20</u>
<u>Sand</u>	<u>20</u>	<u>150</u>

WELL LOCATION:
 sec. 36 T. 3 N. R. 4 E
5 miles S of Wagon
 (distance) (direction) (nearest town)

WELL PURPOSE: home
 (home, irrigation, municipal, industrial)

- WELL COMPLETION DATA:
- diameter (inches) 2"
 - total depth (feet) 158
 - static water level (feet) 53 below above top of ground.
 - casing Plastic, 140
 (material) (depth)
2" if telescope see back.
 (size)
 - screen 5' 140
 (length) (depth to top)
2" Plastic
 (size) (material)
 - pump 1/2 6
 (HP) (yield gpm)
Just Willbar 20
 (type power)
 - electric log: Yes
 (yes or no)
M. G. S.
 (organization running log)
 - how well bottom plugged B/W plug


DRILLERS REMARKS:

SEP 12 1969


MISSISSIPPI
 WATER COMMISSIONERS

If well telescopes please sketch and show depths.

GROUND LEVEL

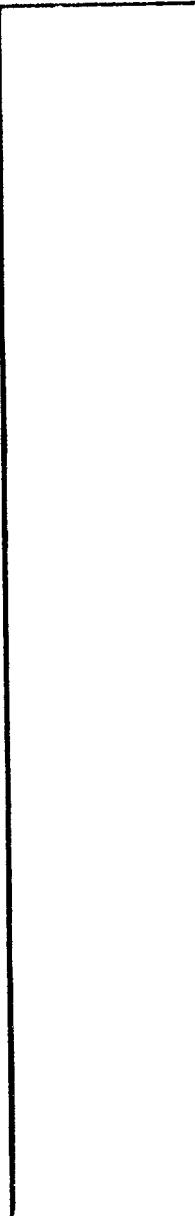

If more than one screen, show locations of each on sketch.

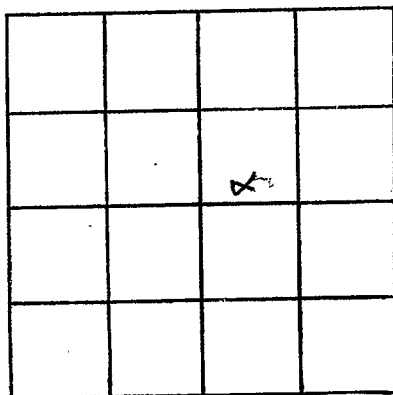

SECTION 86

Please indicate well location X.

ADDITIONAL INFORMATION

Multiple horizontal lines provided for entering additional information.