

Rankin
W48
10-27-69

MISSISSIPPI
BOARD OF WATER COMMISSIONERS
416 North State Street
Jackson, Mississippi 39201

CODED

WATER WELL DRILLERS LOG

10-27-69 date well completed
W. G. Butler firm name
Rankin county well located

LANDOWNER:

S. G. Newsome
Mendenhall, Miss
(mailing address) Rt.

description of formations encountered

from

to

Clay + Rock	0	20
Clay	20	30
Sand + Clay	30	40
Sand + Rock	40	50
Rock + Clay	50	60
Clay	70	80
Sand	80	87
Clay	87	90
Clay + Sand	90	110
Sand	110	120
Sand + Clay	120	130

WELL LOCATION:

sec. 35 T. 3 N. R. 4 E
S W
5 miles South of Johns
(distance) (direction) (nearest town)

WELL PURPOSE:

Home (home, irrigation, municipal, industrial)

WELL COMPLETION DATA:

- (1) diameter (inches) 2"
- (2) total depth (feet) 130'
- (3) static water level (feet) 1' below above top of ground.
- (4) casing 2" (size) If telescope see back.
92 1/2' (material) 95' (depth)
- (5) screen 2" (size) 5' (length) 95' (depth to top)
2" (size) 55' (material)
- (6) pump 1 (HP) 6 (yield gpm)
Electric (type power)
- (7) electric log No (yes or no)
- (organization running log)
- (8) how well bottom plugged 2" BWV


DRILLERS REMARKS:

DEC 15 1969

MISSISSIPPI
BOARD OF WATER COMMISSIONERS
JACKSON, MISSISSIPPI

If well telescopes please sketch and show depths.

GROUND LEVEL

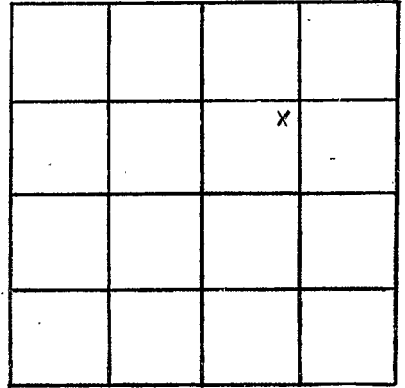

SECTION 35

Please indicate well location X.

ADDITIONAL INFORMATION

If more than one screen,
show locations of each on sketch.