

**MISSISSIPPI
BOARD OF WATER COMMISSIONERS**
416 North State Street
Jackson, Mississippi 39201

CODED

WATER WELL DRILLERS LOG

Rankin
W49
12-9-69

Dec 9 1969 W.A. Butler RANKIN
date well completed firm name county well located

LANDOWNER:

C.A. Dixon
Pt. 1. Braxton, Miss
(mailing address)

description of formations encountered

from to

<u>Red clay + Rock</u>	<u>1</u>	<u>10</u>
<u>SAND</u>	<u>10</u>	<u>30</u>
<u>SAND, CLAY, + GRAVEL</u>	<u>30</u>	<u>40</u>
<u>CLAY + SAND</u>	<u>40</u>	<u>76</u>
<u>Rock + CLAY</u>	<u>76</u>	<u>120</u>
<u>CLAY</u>	<u>120</u>	<u>130</u>
<u>CLAY + Rock</u>	<u>130</u>	<u>150</u>
<u>CLAY</u>	<u>150</u>	<u>170</u>
<u>Rock + CLAY</u>	<u>170</u>	<u>180</u>
<u>SAND + CLAY</u>	<u>180</u>	<u>190</u>
<u>CLAY + Rock</u>	<u>190</u>	<u>200</u>
<u>Rock</u>	<u>200</u>	<u>210</u>
<u>Rock + CLAY</u>	<u>210</u>	<u>263</u>
<u>Rock</u>	<u>213</u>	<u>295</u>
<u>SAND</u>	<u>295</u>	<u>305</u>
<u>SAND + Rock</u>	<u>305</u>	<u>326</u>
<u>SAND + CLAY</u>	<u>326</u>	<u>347</u>
<u>SAND + Rock</u>	<u>347</u>	<u>364</u>

WELL LOCATION:

sec 32 T. 3 (N) R. 4 (E)
S W
5 miles S of Johns
(distance) (direction) (nearest town)

WELL PURPOSE: Home
(home, irrigation, municipal, industrial)

WELL COMPLETION DATA:

- (1) diameter (inches) 2"
- (2) total depth (feet) 364
- (3) static water level (feet) _____ below above top of ground.
- (4) casing 2 1/2" 336'
(material) (depth)
2" if telescope see back.
(size)
- (5) screen 15' 336'
(length) (depth to top)
2" SS
(size) (material)
- (6) pump AIRCORD 5
(HP) (yield gpm)
Solaheis
(type power)
- (7) electric log No.
(yes or no)
- (organization running log) _____
- (8) how well bottom plugged 2" Bull


DRILLERS REMARKS:

DEC 15 1969

MISSISSIPPI BOARD OF WATER COMMISSIONERS

If well telescopes please sketch and show depths.

GROUND LEVEL

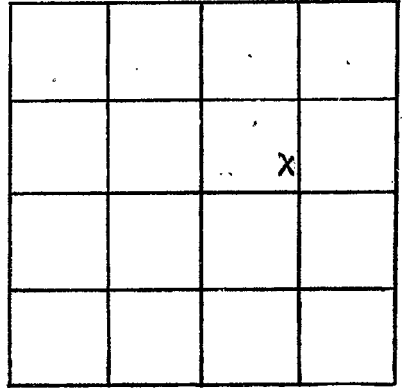

SECTION 32

Please indicate well location X.

ADDITIONAL INFORMATION

If more than one screen,
show locations of each on sketch.