

Rankin
W 50
2-27-70

MISSISSIPPI
BOARD OF WATER COMMISSIONERS
416 North State Street
Jackson, Mississippi 39201

COPIED

WATER WELL DRILLERS LOG

7-11-27 1969 W. G. Butler Rankin
date well completed firm name county well located

LANDOWNER:
Wade Patrick
Braxton, Rt. 1 - Miss
(mailing address)

description of formations encountered	from	to
CLAY	0	10
CLAY & SAND	10	20
Rock 1 + clay	20	95
SAND	95	105
Rock	105	110

WELL LOCATION:
sec. 8 T. 3 (N) R. 4 (E)
S W
5 miles S.W. of JONES
(distance) (direction) (nearest town)

WELL PURPOSE:
(home, irrigation, municipal, industrial)

- WELL COMPLETION DATA:
- (1) diameter (inches) 2"
 - (2) total depth (feet) 110
 - (3) static water level (feet) 50 below top of ground.
 - (4) casing 2" galv. 100' (material) (depth)
2" if telescope see back. (size)
 - (5) screen 10' 95' (length) (depth to top)
2" SS. (size) (material)
 - (6) pump Aircomp. (HP) (yield gpm)
Electric (type power)
 - (7) electric log No (yes or no)
(organization running log)
 - (8) how well bottom plugged 2" B.V.

COPIED


MAR 9 - 1970

MISS. BD. OF
WATER COM.

DRILLERS REMARKS:

If well telescopes please sketch and show depths.

GROUND LEVEL

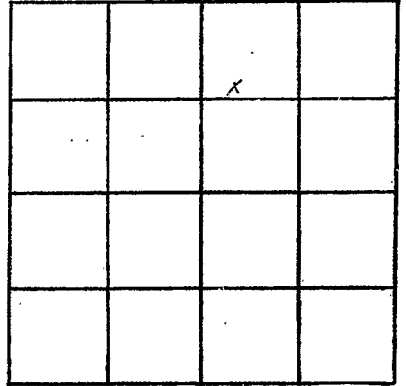

SECTION 8

Please indicate well location X.

ADDITIONAL INFORMATION

If more than one screen,
show locations of each on sketch.