

Rankin
W 52
6-5-70

MISSISSIPPI
BOARD OF WATER COMMISSIONERS
416 North State Street
Jackson, Mississippi 39201

CODED

WATER WELL DRILLERS LOG

June 5 1970 W. G. Butler Rankin
date well completed firm name county well located

LANDOWNER:

ASZ. SIMMONS

description of formations encountered

from

to

Mendonhall
(mailing address)

CLAY & Rock
CLAY & SAND
SAND
CLAY

0 60
60 65
65 73
73 80

WELL LOCATION:

sec 25 T 3 N R 4 E
4 miles SW of Pickett
(distance) (direction) (nearest town)

WELL PURPOSE:

Home
(home, irrigation, municipal, industrial)

WELL COMPLETION DATA:

- (1) diameter (inches) 2"
- (2) total depth (feet) 80'
- (3) static water level (feet) 50' below above top of ground.
- (4) casing galv., 68' (material) (depth)
2" (size) if telescope see back.
- (5) screen 5' 68' (length) (depth to top)
2" (size) SS (material)
- (6) pump 1/2 (HP) 5 (yield gpm)
2 electric (type power)
- (7) electric log NO (yes or no)

CODED

(organization running log)

(8) how well bottom plugged 2" BWV


111 2 19/0

MISS. BD. OF
WATER COMM.

DRILLERS REMARKS:

If well telescopes please sketch and show depths.

GROUND LEVEL

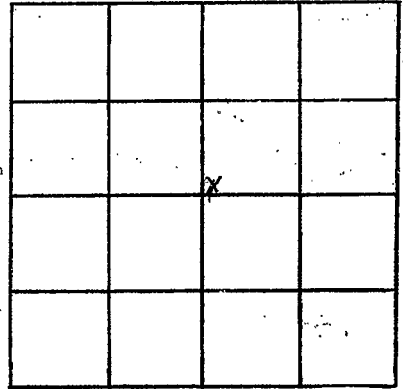

SECTION 25

Please indicate well location X.

ADDITIONAL INFORMATION

If more than one screen,
show locations of each on sketch.