

RANKIN

W56

10-12-70

MISSISSIPPI
 BOARD OF WATER COMMISSIONERS
 416 North State Street
 Jackson, Mississippi 39201

CODED

WATER WELL DRILLERS LOG

10/12/70 1970 W. G. Butler Rankin
 date well completed firm name county well located

LANDOWNER:

Charles Taylor

Mendenhall, Miss

Rt- (mailing address)

WELL LOCATION:

sec. 15 T-3 N R-4 E
 2 3/4 miles SW of Johns
 (distance) (direction) (nearest town)

WELL PURPOSE:

None (home, irrigation, municipal, industrial)

WELL COMPLETION DATA:

- (1) diameter (inches) 2"
- (2) total depth (feet) 39
- (3) static water level (feet) - below above top of ground.
- (4) casing galv. 30' (material) (depth)
 2" (size) if telescope see back.
- (5) screen 5' 30' (length) (depth to top)
 2" (size) SS (material)
- (6) pump 1/2 (HP) 3 (yield gpm)
 Electric (type power)
- (7) electric log No (yes or no)
- (organization running log)
- (8) how well bottom plugged 2" BWV

description of formations encountered

from to

Clay	0	10
Sand	10	20
Sand + Rock	20	30
Sand	30	37
Rock	37	39

CODED


DRILLERS REMARKS:

NOV 16 1970

MISS. BD. OF WATER COMMISSIONERS

If well telescopes please sketch and show depths.

GROUND LEVEL

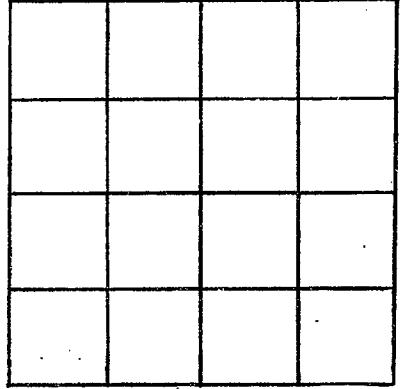

SECTION _____

Please indicate well location X.

ADDITIONAL INFORMATION

If more than one screen, show locations of each on sketch.