

CODED

MISSISSIPPI
BOARD OF WATER COMMISSIONERS
416 North State Street
Jackson, Mississippi 39201

1st Hole

WATER WELL DRILLERS LOG

RANKIN
W57
10-10-70

Oct 10 19 70 W. H. Butler Rankin
date well completed firm name county well located

LANDOWNER: Charles Taylor
Mendenhall, Miss
Rt. (mailing address)
WELL LOCATION:
sec. 15 T. 3 S. R. 4 E. W.
miles _____ of _____
(distance) (direction) (nearest town)

WELL PURPOSE: Home
(home, irrigation, municipal, industrial)

WELL COMPLETION DATA:

- (1) diameter (inches) 3"
- (2) total depth (feet) 190'
- (3) static water level (feet) _____ below
top of ground. above
- (4) casing NO Well
(material) (depth)
if telescope see back.
(size)
- (5) screen _____
(length) (depth to top)
(size) (material)
- (6) pump _____
(HP) (yield gpm)
(type power)
- (7) electric log _____
(yes or no)
(organization running log)
- (8) how well bottom plugged _____

description of formations encountered	from	to
Clay, Rock + Sand	0	10
Sand + Clay	10	30
Sand, Rock + Clay	30	40
Rock + Sand	40	50
Rock + Clay	50	70
Clay + Sand	70	80
Clay + Rock	80	100
Rock + Clay	100	120
Clay + Sand	120	135
Clay	135	160
Sand + Clay	160	170
Clay, Rock + Sand	170	180
Clay + Rock	180	190

CODED


NOV 16 1970

MISS. BD. OF
WATER COMM.

DRILLERS REMARKS: Nothing
to make hole in this hole, move
to another spot.

If well telescopes please sketch and show depths.

GROUND LEVEL

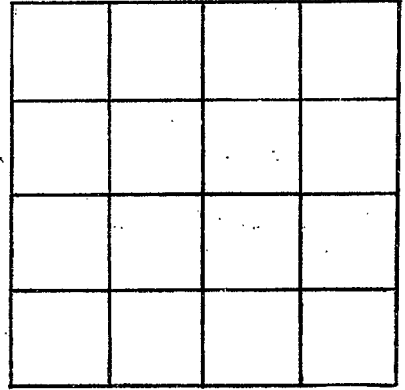

SECTION _____

Please indicate well location X.

ADDITIONAL INFORMATION

If more than one screen, show locations of each on sketch.