

MISSISSIPPI
BOARD OF WATER COMMISSIONERS
416 North State Street
Jackson, Mississippi 39201

CODED

WATER WELL DRILLERS LOG

RANKIN
W58
11-19-70

NOV 19 19 70 M. H. Butler RANKIN
date well completed firm name county well located

LANDOWNER: M. W. Conerly
Mendenhall,
Miss
(mailing address)

description of formations encountered	from	to
<u>Sand + Clay</u>	<u>0</u>	<u>15</u>
<u>Clay</u>	<u>15</u>	<u>20</u>
<u>Rock + Clay</u>	<u>20</u>	<u>120</u>
<u>Clay + Sand</u>	<u>120</u>	<u>150</u>
<u>Clay + Rock</u>	<u>150</u>	<u>157</u>

WELL LOCATION:
sec. 20 T. 3 N. R. 4 E
S W
1 miles SW of Cato
(distance) (direction) (nearest town)

WELL PURPOSE: Home
(home, irrigation, municipal, industrial)

WELL COMPLETION DATA:

(1) diameter (inches) 2"

(2) total depth (feet) 157'

(3) static water level (feet) _____ below above top of ground.

(4) casing 9214, 140,
(material) (depth)
2" if telescope see back.
(size)

(5) screen 80', 140
(length) (depth to top)
2", SS
(size) (material)

(6) pump Air Comp.
(HP) (yield gpm)
Electric
(type power)

(7) electric log NO
(yes or no)

(organization running log)

CODED

(8) how well bottom plugged 2" BWV


DEC 7 1970

DRILLERS REMARKS:

MISS. BOARD OF WATER COMMISSIONERS

If well telescopes please sketch and show depths.

GROUND LEVEL

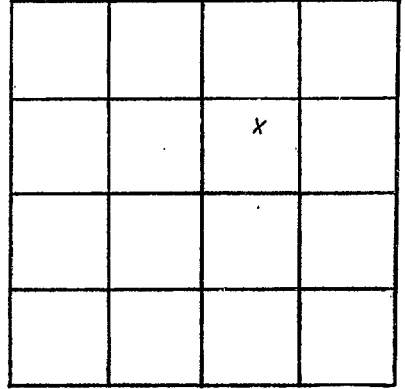

SECTION 20

Please indicate well location X.

ADDITIONAL INFORMATION

If more than one screen,
show locations of each on sketch.