

RANKIN MISSISSIPPI BOARD OF WATER COMMISSIONERS

~~Q24~~ W 61

11-1-62

WATER WELL DRILLERS LOG

CODED

Date: NOV. 1, 1962, Driller: W. G. Butler County Smith

(Name)

(1) Owner of Land: <u>Wade Patrick</u>	Description & Color of Materials Sand, Clay, Red Clay, Shell, etc.	Thick- ness- Feet	Depth Feet
(Name)	<u>Clay & Rock</u>	<u>1-5</u>	
<u>Brandon H. Miss</u>	<u>Chalk & sand</u>	<u>5-10</u>	
(Address)	<u>Rock</u>	<u>10-20</u>	
(2) Location: <u>1/4, 1/4, Sec. 9 T3 R1 E</u>	<u>Rock + Chalk</u>	<u>20-30</u>	
<u>5 miles S. West of Cato</u>	<u>Rock</u>	<u>30-40</u>	
(distance) (direction) (Nearest Town)	<u>Rock + Chalk</u>	<u>40-70</u>	
(3) Topography: <input checked="" type="checkbox"/> (Hilly) <input type="checkbox"/> (Flat) <input type="checkbox"/> (Level)	<u>Sand + Chalk</u>	<u>70-80</u>	
(4) Purpose of Well: <u>Domestic</u>	<u>Chalk</u>	<u>80-85</u>	
(Domestic Irrigation Municipal, Industrial, Other)	<u>Sand</u>	<u>85-100</u>	

Information upon completion of well:

- (1) Diameter 2 inches.
- (2) Total Depth 100 feet.
- (3) Water Level 30 feet below top of ground.
- (4) Cased to 90, Size 2"
- (5) Screen: Size 2", Length 10
- (6) Were any formations sealed against pollution?


 yes, no.

If YES depth of formation

Why

Drillers Remarks:

CODED

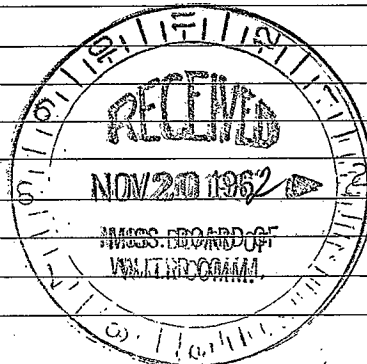

(Use Back Side)

Well No.

