

RANKIN  
 SIMPSON  
 W 65  
 7-8-77

MISSISSIPPI  
 BOARD OF WATER COMMISSIONERS  
 416 North State Street  
 Jackson, Mississippi 39201

CODED

WATER WELL DRILLERS LOG

7-8 1977 JACKSON SIMPSON  
 date well completed firm name county well located


LANDOWNER: HINSWORTH, R. W.	description of formations encountered	from	to
(mailing address)	CLAY SAND	0	40 80
WELL LOCATION: sec. 15 T-3 N R-4 E miles of (distance) (direction) (nearest town)			
WELL PURPOSE: (home, irrigation, municipal, industrial)			
WELL COMPLETION DATA:			
(1) diameter (inches) 4"			
(2) total depth (feet) 78'			
(3) static water level (feet) 20 below top of ground.			
(4) casing PVC, 68' (material) (depth) 4" (size) if telescope see back.			
(5) screen 10' 68' (length) (depth to top) 4" (size) PVC (material)			
(6) pump 1/2 15 (HP) (yield gpm) MPC (type power)			
(7) electric log YES (yes or no) MCS (organization running log)			
(8) how well bottom plugged B.W.U.			
DRILLERS REMARKS:			

CODED

RECEIVED  
 SEP 16 1977

If well telescopes please sketch and show depths.

GROUND LEVEL

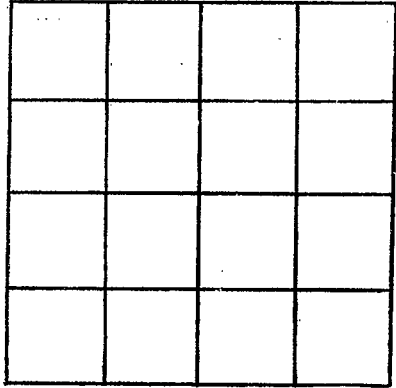

SECTION \_\_\_\_\_

Please indicate well location X.

ADDITIONAL INFORMATION

If more than one screen, show locations of each on sketch.