

RANKIN
W66
Z178
Elev 443

MISSISSIPPI
 BOARD OF WATER COMMISSIONERS **CODED**
 416 North State Street
 Jackson, Mississippi 39201
 MS-GW-01559
 WATER WELL DRILLERS LOG

February 1978 I.M. Parks Drilling Co. Rankin
 date well completed firm name county well located

LANDOWNER:	description of formations encountered	from	to
Southeast Rankin Water Assn. Rankin County, MS (mailing address)			
WELL LOCATION:	Sand - red	80	100'
sec. 26 T 3 N R 4 E S W	Sand w/clays + shales	100	200'
4 miles south of Cato (distance) (direction) of community (nearest town)	Clay	200	260'
WELL PURPOSE: Municipal (home, irrigation, municipal, industrial)	Clay, sand + shales	260	408'
WELL COMPLETION DATA:	Clay w/Gumbo	408	838'
(1) diameter (inches) 10 3/4	Sand w/shale + clays	838	980'
(2) total depth (feet) 1080'	Good streaks broken	980	1080'
(3) static water level (feet) 252' below top of ground.	w/ lignite + shale		
(4) casing steel, 940' (material) (depth)			
10 3/4 x 6 if telescope see back. (size)			
(5) screen 50' 960' (length) (depth to top)			
6" stainless steel (size) (material)			
(6) pump 40 200" (HP) (yield gpm)			
3Ø (type power)			
(7) electric log wro (yes or no)			
U.S. Geological Survey (organization running log)			
(8) how well bottom plugged SAW - tooth w/ B.P.V.			
DRILLERS REMARKS:			

CODED


RECEIVED
 MAY 18 1978

MISS. BD. OF WATER COMM

(X)

If well telescopes please sketch and show depths.

GROUND LEVEL

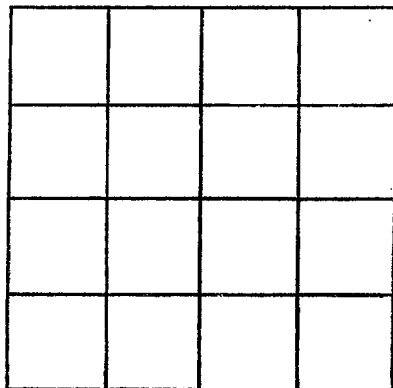

SECTION _____

Please indicate well location X.

ADDITIONAL INFORMATION

If more than one screen, show locations of each on sketch.