

CODED CODED

CODED

Ranken  
X 35  
8-12-68  
U.S.G.S.

MISSISSIPPI  
BOARD OF WATER COMMISSIONERS  
416 North State Street  
Jackson, Mississippi 39201

WATER WELL DRILLERS LOG

CODED  
Ranken

~~8-12-68~~ 19 ~~Ranken~~ ~~Ranken~~ ~~Mississippi~~  
date well completed firm name county well located

COMANS DRILLING SERVICE

LANDOWNER: UNION  
Water Assoc  
RANKEN COUNTY Brandon  
(mailing address)  
WELL LOCATION: SW NW SE  
sec. 11 T. 3 (N) R. 5 (E)  
S W  
3 miles N of Puckett  
(distance) (direction) (nearest town)

description of formations encountered	from	to
SANDY CLAY	0	20
SAND + CLAY	20	75
SAND	75	160
CLAY + SHAL	160	260
Very Hard clay to Drill	260	600
CLAY + SHAL	600	680
SANDY CLAY	680	840
SAND	840	846
CLAY	846	940
SAND + CLAY + LARGES	940	1040
FINE SAND + CLAY	1040	1160
SANDY CLAY	1160	1163
SAND .008"	1163	1200
SANDY CLAY	1200	1240
SAND .008"	1220	1240
CLAY	1240	1246
SAND .006"	1246	1310
SAND + CLAY	1310	1348

WELL PURPOSE: MUNICIPAL  
(home, irrigation, municipal, industrial)

WELL COMPLETION DATA:

- (1) diameter (inches) 6"
- (2) total depth (feet) 1238
- (3) static water level (feet) 187 below above top of ground.
- (4) casing Steel, 1150,  
(material) (depth)  
4" if telescope see back.  
(size)
- (5) screen 50, 1165  
(length) (depth to top)  
4", STEEL JOHNSON  
(size) (material)
- (6) pump 25, 150  
(HP) (yield gpm)  
Electric  
(type power)
- (7) electric log X  
(yes or no)  
91565  
(organization running log)
- (8) how well bottom plugged Feat  
Back Wash Valve

DRILLERS REMARKS:

CODED

CODED


CODED

FEB 12 1969


MISS. D. OF  
WATER COM.

(X)

If well telescopes please sketch and show depths.

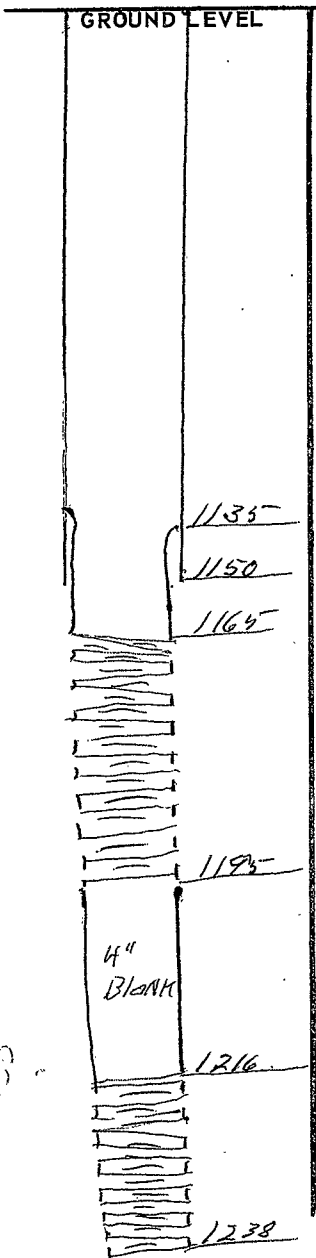

If more than one screen, show locations of each on sketch.

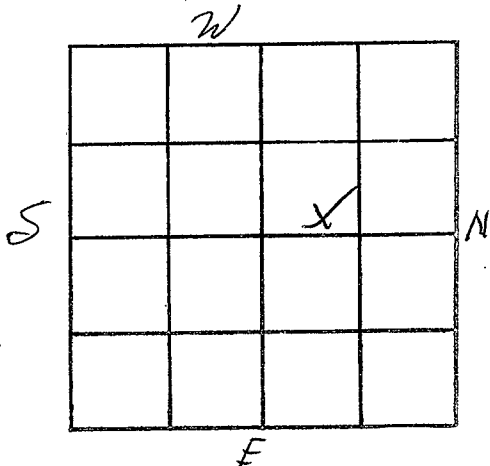

SECTION 11

Please indicate well location X.

**ADDITIONAL INFORMATION**

*This is the second well that was drilled at this location. We lost the first one. It was cased to 842.*

*I mention this, because Electric Logs on file shows the other well to be cased at a different depth.*