

RANKIN MISSISSIPPI BOARD OF WATER COMMISSIONERS

X36

7-12-60

WATER WELL DRILLERS LOG

X-300  
**CODED**

Date: 7/12, 1960, Driller: W. H. Butler County: with  
(Name) Rankin

(1) Owner of Land: C. G. Cook  
(Name)  
Mendenhall Pt. 1. Miss  
(Address)

(2) Location: 1/4, 1/4, Sec. 36 T. 3 R. 5,  
11 miles North of Maguer  
(distance) (direction) (Nearest Town)

(3) Topography: Level  
(Hilly) (Flat) (Level)

(4) Purpose of Well: Domestic  
(Domestic Irrigation  
Municipal, Industrial, Other)

Description & Color of Materials Sand, Clay, Red Clay, Shell, etc.	Thick- ness Feet	Depth Feet
<u>Sand, + top soil</u>	<u>2'</u>	<u>12"</u>
<u>Chalk + Clay</u>	<u>8'</u>	
<u>Sand</u>	<u>16'</u>	
<u>Chalk</u>	<u>4'</u>	

Information upon completion of well:

(1) Diameter 2 inches.


(2) Total Depth 30 feet.

(3) Water Level 12 feet below top of ground.

(4) Cased to 21', Size 2"

(5) Screen: Size 1 1/4", Length 5'

(6) Were any formations sealed against pollution?  
no.

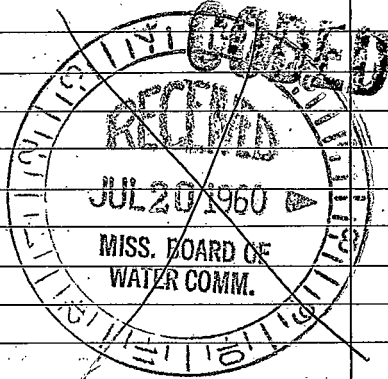

If YES depth of formation \_\_\_\_\_

Why \_\_\_\_\_

Drillers Remarks: \_\_\_\_\_

(Use Back Side)

Well No. \_\_\_\_\_

