

RANKIN MISSISSIPPI BOARD OF WATER COMMISSIONERS.

X 38

8-10-60

WATER WELL DRILLERS LOG

X - 301  
**CODED**

Date: Aug 10, 1960, Driller: W. G. Butlers County Rankin  
(Name)

(1) Owner of Land: Ethel Moore  
(Name)  
Brandon Rt 2 - Miss  
(Address)

(2) Location: NW 1/4, SE 1/4, Sec. 4 T3R5  
4 miles North, of Puckett  
(distance) (direction) (Nearest Town)

(3) Topography:  (Hilly)  (Flat)  (Level)

(4) Purpose of Well: DOMESTIC  
(Domestic Irrigation  
Municipal, Industrial, Other)

Description & Color of Materials Sand, Clay, Red Clay, Shell, etc.	Thick- ness Feet	Depth Feet
<del>1st</del> Ft. top		
Soil	1'	1
CLAY	10'	11
Mucky Sand + Chalk	11'	30'
" " " "	"	"
Gray + Blue Chalk	30'	150'
Rock Formation	150'	160
Real Fine Sand	160'	170
Rock Formation	170'	220
Med. Sand	220'	227

Information upon completion of well:

(1) Diameter 2 inches.

(2) Total Depth 227 feet.

(3) Water Level 70 feet below top of ground.

(4) Cased to \_\_\_\_\_, Size 2"

(5) Screen: Size 2", Length 15'


(6) Were any formations sealed against pollution?  
\_\_\_\_\_ yes;  no.

If YES depth of formation \_\_\_\_\_

Why \_\_\_\_\_

Drillers Remarks: \_\_\_\_\_

**CODED**

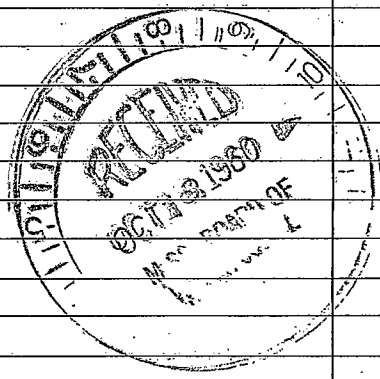

(Use Back Side)

Well No.

