

RANKIN MISSISSIPPI BOARD OF WATER COMMISSIONERS

X 41
5-4-61

WATER WELL DRILLERS LOG

CODED

X 305

Date: MAY 4, 1961, Driller: W.G. Butler County SMITH
(Name) Rankin

- (1) Owner of Land: Otis Miley
(Name)
Brandon Miss-Rt
(Address)
- (2) Location: NW 1/4, NW 1/4, Sec. 11 T3R5
5 miles North, of Puckett
(distance) (direction) (Nearest Town)
- (3) Topography: (Hilly) (Flat) (Level)
- (4) Purpose of Well: Domestic
(Domestic Irrigation, Municipal, Industrial, Other)


Description & Color of Materials Sand, Clay, Red Clay, Shell, etc.	Thick- ness Feet.	Depth Feet
Clay	1 to 10	
Blue Chalk	10 to 25	
sands	25 - 30	
sand + chalk	30 - 40	
" "	40 - 45	
Chalk	45 - 50	
sand	50 - 60	
sand + chalk	60 - 65	
sand	65 - 95	
chalk + sand	95 - 100	
Blue sand	100 - 110	
Blue chalk + sand	110 - 130	
sand	130 - 141	

Information upon completion of well:

- (1) Diameter 2 inches.
- (2) Total Depth 141 feet.
- (3) Water Level 65 feet below top of ground.
- (4) Cased to 126', Size 2"
- (5) Screen: Size 2", Length 15'
- (6) Were any formations sealed against pollution?
_____ yes, _____ no.

If YES depth of formation _____
Why _____
Drillers Remarks: _____

CODED

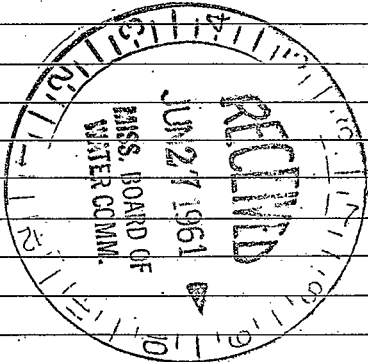

(Use Back Side)

Well No.

Handwritten header text, possibly a title or date, located at the top of the page.

1
2
Vertical handwritten text on the right side of the page, possibly a list or notes.

