

RANKIN

MISSISSIPPI BOARD OF WATER COMMISSIONERS

X 42  
4-15-61

WATER WELL DRILLERS LOG

**CODED**

306

Date: April 15, 1961, Driller: W. G. Butler County Smith  
(Name) Rankin

(1) Owner of Land: Galilee Church  
(Name)  
Mendenhall Miss  
(Address)

(2) Location: SW 1/4, SE 1/2, Sec. 36 T. 3 R. 5  
3 miles South E of Puckett  
(distance) (direction) (Nearest Town)

(3) Topography: L  
(Hilly) (Flat) (Level)

(4) Purpose of Well: Domestic  
(Domestic Irrigation  
Municipal, Industrial, Other)

Description & Color of Materials Sand, Clay, Red Clay, Shell, etc.	Thick- ness Feet	Depth Feet
Chalk	1-15	
Sand + Chalk	15-30	
Chalk	30-40	
Sand	40-45	
Chalk + Rock	45-65	
Sand	65-80	

Information upon completion of well:

(1) Diameter: 2 inches.

(2) Total Depth: 80 feet.

(3) Water Level: 20 feet below top of ground.

(4) Cased to: 75, Size 2

(5) Screen: Size 1/4, Length 5'


(6) Were any formations sealed against pollution?  
\_\_\_\_\_ yes, \_\_\_\_\_ no.

**CODED**

If YES depth of formation \_\_\_\_\_

Why \_\_\_\_\_

Drillers Remarks: \_\_\_\_\_

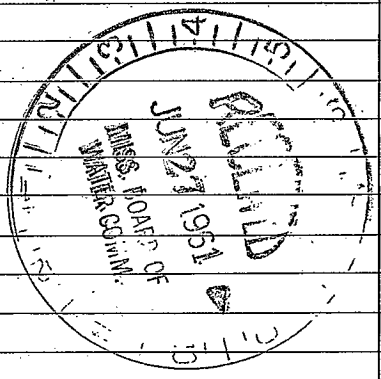

(Use Back Side)

Well No.

Handwritten notes, possibly bleed-through from the reverse side of the page. The text is extremely faint and illegible, appearing as scattered ink marks and ghostly outlines of words. Some faint fragments are visible, such as "K... ..", "S... ..", and "A... ..".