

X43
6-8-61

X 307
Rankin

WATER WELL DRILLERS LOG

Date: June 8, 1961, Driller: W. G. Butcher Smith
(Name)

CODED

(1) Owner of Land: Puckett School
(Name)
Puckett Miss.
(Address)

(2) Location: S 20 Sub 1/4, NW 1/4, Sec. 22 T 35 R 5E
In Puckett
miles (distance) of (direction) (Nearest Town)

(3) Topography: _____
(Hilly) (Flat) (Level)

(4) Purpose of Well: _____
(Domestic Irrigation
Municipal, Industrial, Other)

Description & Color of Materials Sand, Clay, Red Clay, Shell, etc.	Thick- ness Feet	Depth Feet
Chalk	0	15
Sand + Chalk	15	45
Gumbo	45	110
Sand	110	120
Fine Sand	120	130
Sand	130	138
Gumbo	138	140
Sand	140	158

Information upon completion of well:

(1) Diameter 4 inches.

(2) Total Depth 158 feet.

(3) Water Level 30 feet below top of ground.

(4) Cased to 147, Size 4"

(5) Screen: Size 4", Length 8'


(6) Were any formations sealed against pollution?
_____ yes, _____ no.

CODED

If YES depth of formation _____

Why _____

Drillers Remarks: _____

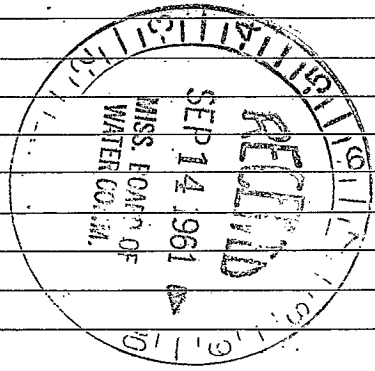

(Use Back Side)

Well No.

Handwritten notes and a grid. The text is very faint and mostly illegible. Some words like "Table" and "of" are visible. A grid of approximately 10x10 cells is present on the left side.

Large area of extremely faint handwritten text, likely bleed-through from the reverse side of the page. The text is mostly illegible but appears to be organized into several paragraphs or sections.