

RANKIN
X 45

WATER WELL DRILLERS LOG

X 300

Date: Aug 9, 1961, Driller: W. G. Butler County Smith
8-9-61 (Name)

CASED

(1) Owner of Land: Puckett school
Teachers Home
Puckett Miss
(Address)

(2) Location: S 1/2 SW 1/4, NW 1/4, Sec. 22, T. 3 R. 5 E
in Puckett
(distance) (direction) (Nearest Town)

(3) Topography: /
(Hilly) (Flat) (Level)

(4) Purpose of Well: Domestic
(Domestic Irrigation
Municipal, Industrial, Other)

Description & Color of Materials Sand, Clay, Red Clay, Shell, etc.	Thick- ness Feet	Depth Feet
Clay	1-5	
sand	5-10	
Chalk	10-15	
sand /	15-20	
Chalk	20-30	
sand & chalk	30-45	
Mostly sand	45-50	
Sand	50-55	
Gumbo	55-100	

Information upon completion of well:

(1) Diameter 2 inches.

(2) Total Depth 100 feet.

(3) Water Level 21 feet below top of ground.

(4) Cased to 42', Size 3"

(5) Screen: Size 2", Length 10'


(6) Were any formations sealed against pollution?
_____ yes, _____ no.

CASED

If YES depth of formation _____

Why _____

Drillers Remarks: _____

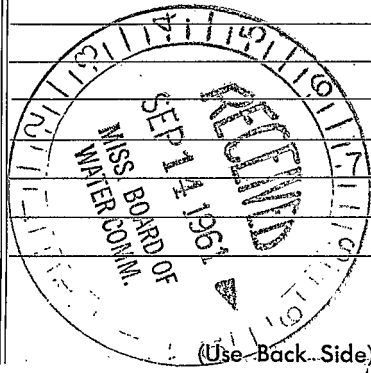

Well No.

