

X 51

8-7-62

WATER WELL DRILLERS LOG

**CODED**

Date: Aug. 7, 1962 Driller: W. G. Butler County: Smith  
 (Name)

(1) Owner of Land: <u>Ralph Calhoun</u> (Name)	Description & Color of Materials Sand, Clay, Red Clay, Shell, etc.	Thick- ness Feet	Depth Feet
<u>Brandon, Miss. Rt 1</u> (Address)	<u>C/24</u> <u>Sand</u>	<u>1-10</u>	<u>10-102</u>
(2) Location: <u>1/4</u> , <u>1/4</u> , Sec. <u>28 13 R5E</u>	<u>Chalk + Rock</u>	<u>102-110</u>	<u>110-120</u>
<u>1</u> miles <u>South</u> of <u>Puckett</u> (distance) (direction) (Nearest Town)	<u>Sand + chalk</u> <u>good sand</u>	<u>120-150</u>	<u>150-170</u>
(3) Topography: <input checked="" type="checkbox"/> (Hilly) <input type="checkbox"/> (Flat) <input type="checkbox"/> (Level)			
(4) Purpose of Well: <u>Domestic</u> (Domestic Irrigation Municipal, Industrial, Other)			

Information upon completion of well:

- (1) Diameter 2 inches.
- (2) Total Depth 170 feet.
- (3) Water Level 50 feet below top of ground.
- (4) Cased to 168, Size 2"
- (5) Screen: Size 2, Length 11
- (6) Were any formations sealed against pollution?  
 \_\_\_\_\_ yes, \_\_\_\_\_ no.

If YES depth of formation \_\_\_\_\_


Why \_\_\_\_\_

Drillers Remarks: \_\_\_\_\_

\_\_\_\_\_

\_\_\_\_\_

**CODED**

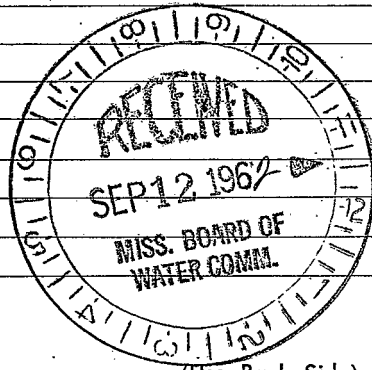

(Use Back Side)

Well No.

1910

John ... ..

...

...

